


T.26S.R.4W.W.M.

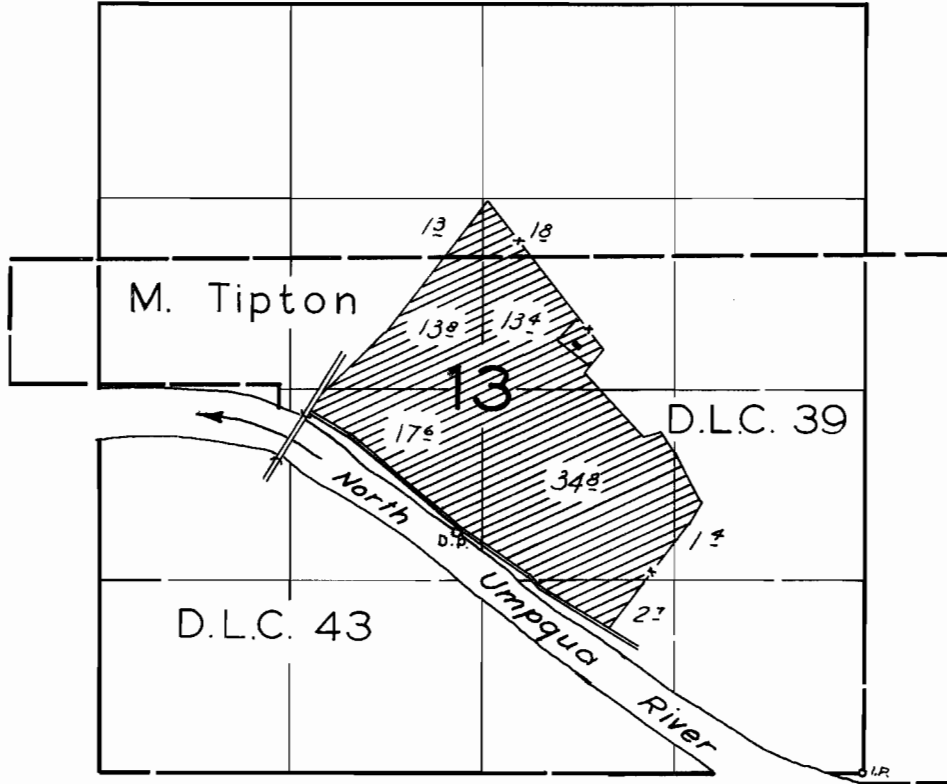

FINAL PROOF SURVEY
UNDER

Application No. 29617. Permit No. 23314.
IN NAME OF

ROBERT MURRAY

Surveyed June 24 1959, by *R.H. Jackson*