


T. 1 S. R. 2 W. W. M.

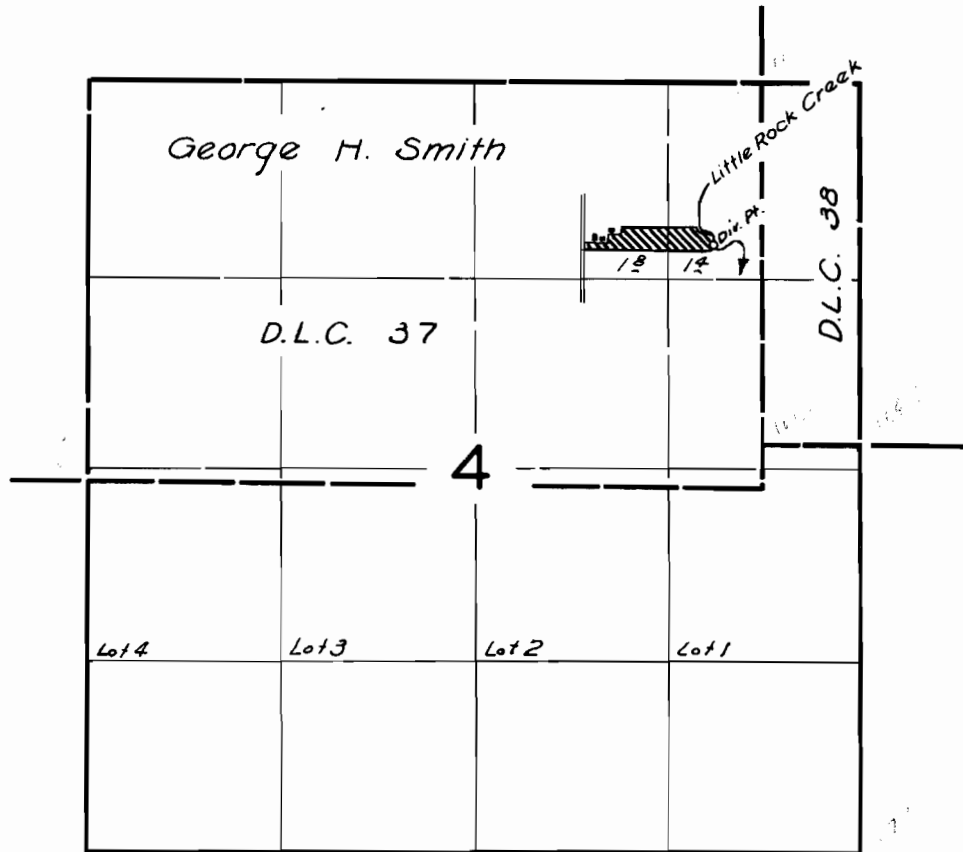

FINAL PROOF SURVEY
UNDER

Application No. 29756. Permit No. 23436
IN NAME OF

CHARLES G. BOYINGTON

Surveyed 4 June 1959, by *R. Jackson*