


T.40 S.R.9 W.W.M.

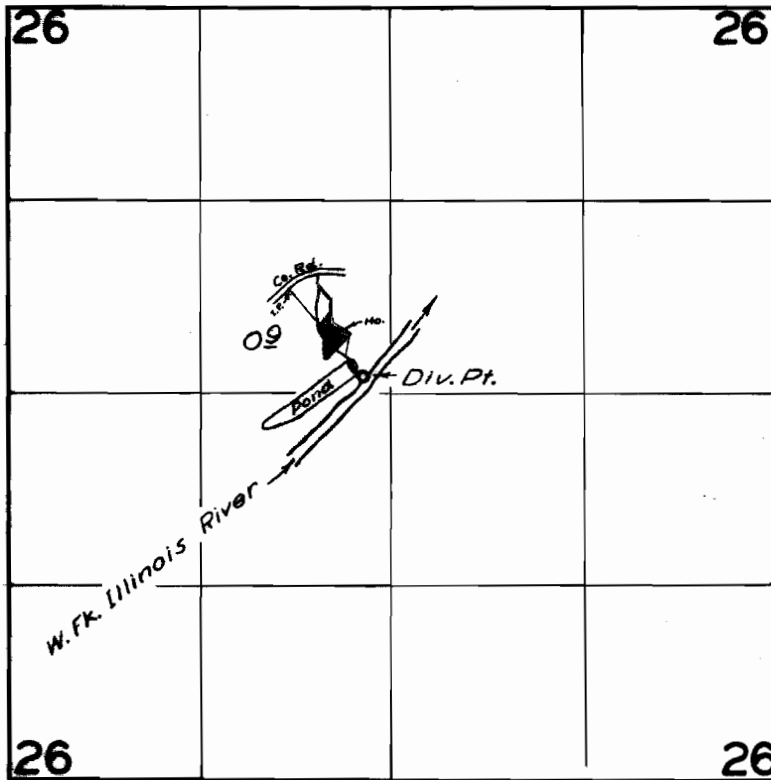

**FINAL PROOF SURVEY**  
UNDER

Application No. 29799 Permit No. 23452  
IN NAME OF

MRS. HELEN A. BOTTEL

Surveyed 14 July 1959, by M. Bieh