


# T. 36S. R. 11E. WM.

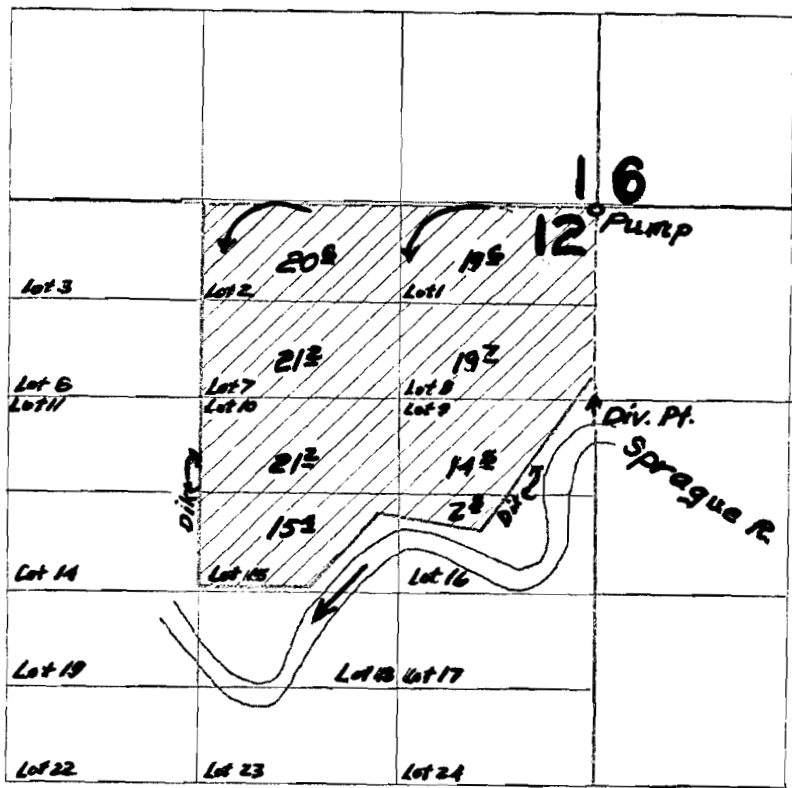

Sprague River

## FINAL PROOF SURVEY

UNDER

Application No. 29840..Permit No. 23466

IN FAVOR OF

George H. & Regina M. Frey

Surveyed Oct. 23 1959, by R. H. Jackson