


T.26S. R.7W.W.M.

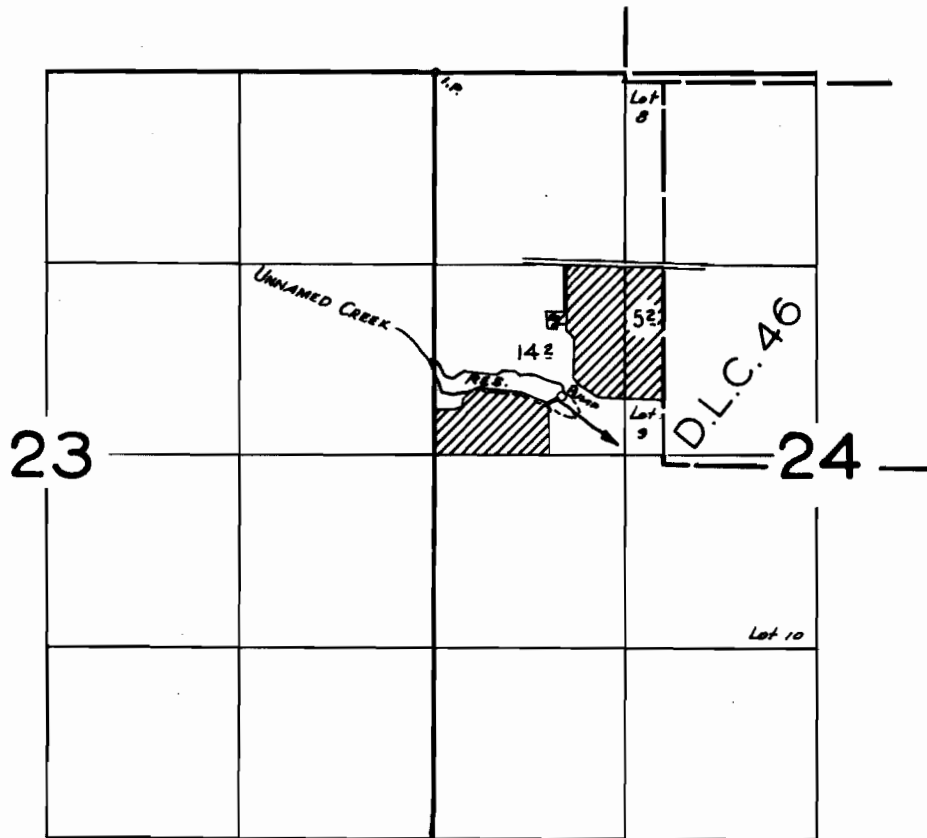

FINAL PROOF SURVEY
UNDER

Application No. ~~28754~~ R-28753 Permit No. ~~23743~~ R-1776
IN NAME OF

..... *RAY E. DOERNER*

Surveyed June 20, 1959, by *R. Jackson*