


T. IS. R. I.W.W.M.

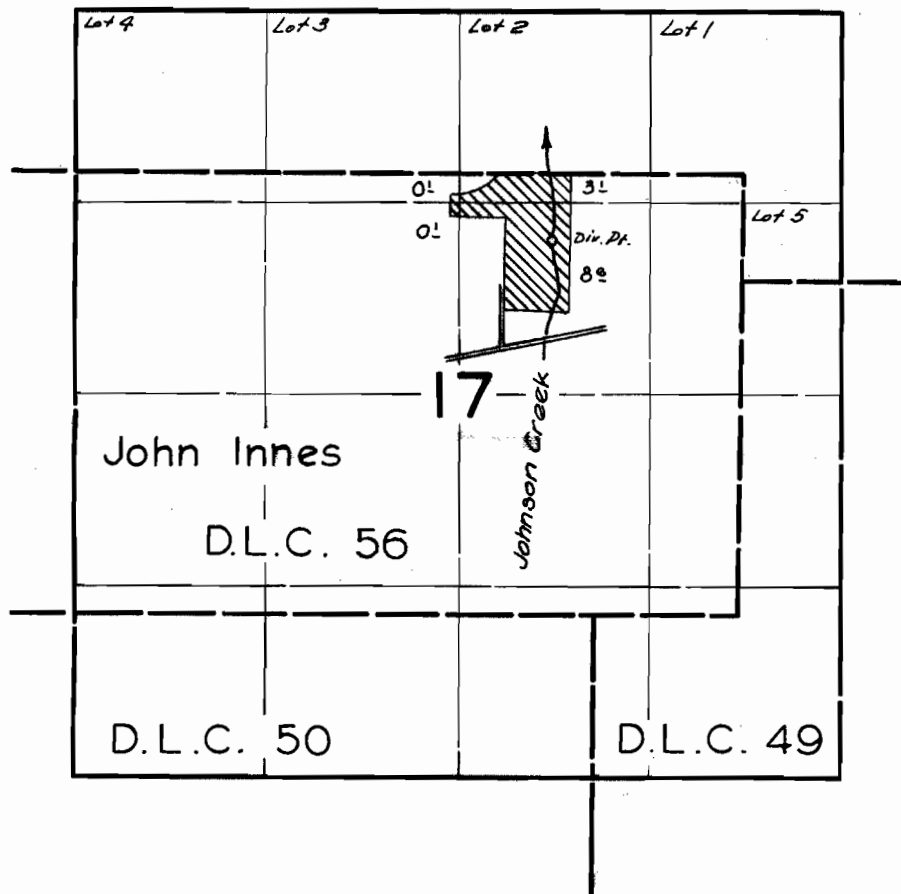

FINAL PROOF SURVEY UNDER

Application No. 29261..... Permit No. 23084.....
IN NAME OF

SUSIE ANNA DAY

Surveyed 3 June 1959, by *R. Jackson*