


T. 14S. R. 1E. W.M.

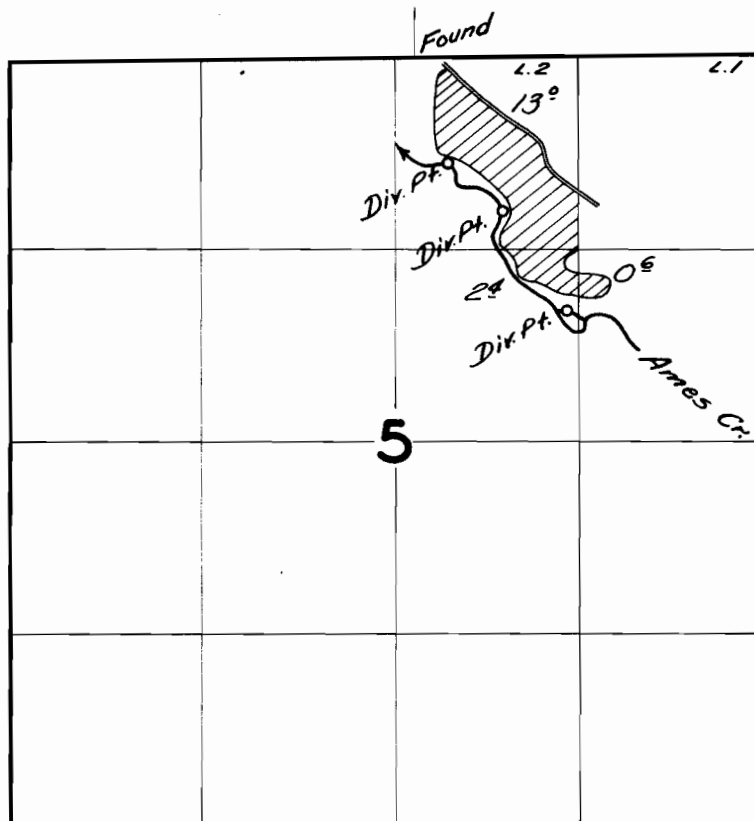

FINAL PROOF SURVEY

UNDER

Application No. 30193 Permit No. 23813

IN NAME OF

George Weddle

Surveyed Sept. 3 1959, by C.O. Bartels