


T. 3S. R. 45E. W.M.

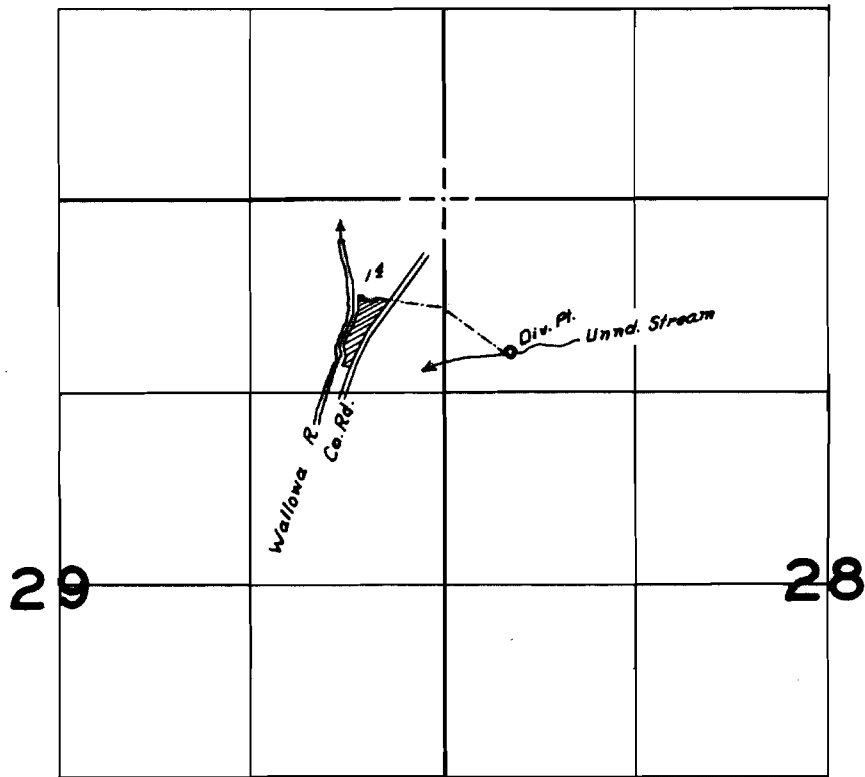

FINAL PROOF SURVEY
UNDER

Application No. 30309 Permit No. 29949
IN NAME OF

T. H. Williamson

Surveyed Aug. 11, 1959, by R. H. Jackson