


T.34 S.R. 6 W.W.M.

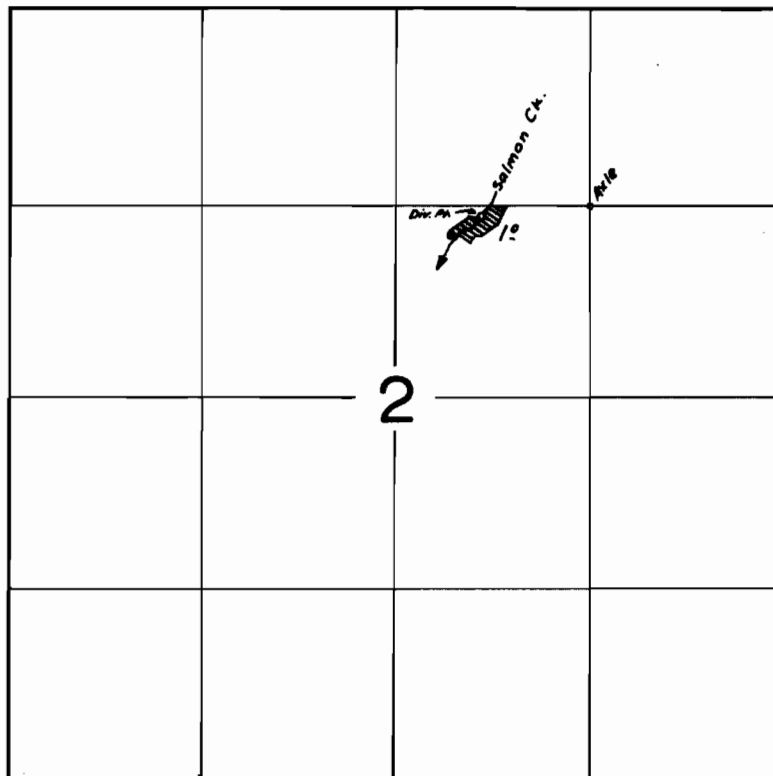

FINAL PROOF SURVEY
UNDER

Application No. 30608.. Permit No. 24099..
IN NAME OF

.....*MARLIN R. BYERS*.....

Surveyed July 25, 1959., by *R. Jackson*