


T.5S. R.2E.W.M.

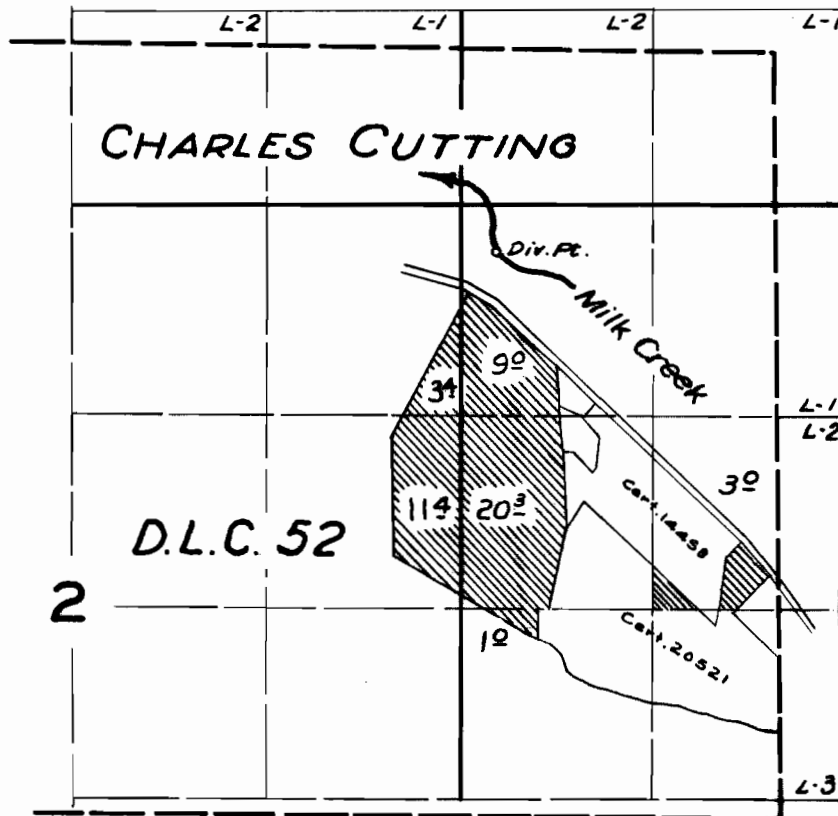

FINAL PROOF SURVEY
UNDER

Application No. 30797 Permit No. 24365
IN NAME OF

FRANK RUSSELL

Surveyed 17 June 1958, by C.O. Bartels.