


T. 2S. R. 1W. W.M.

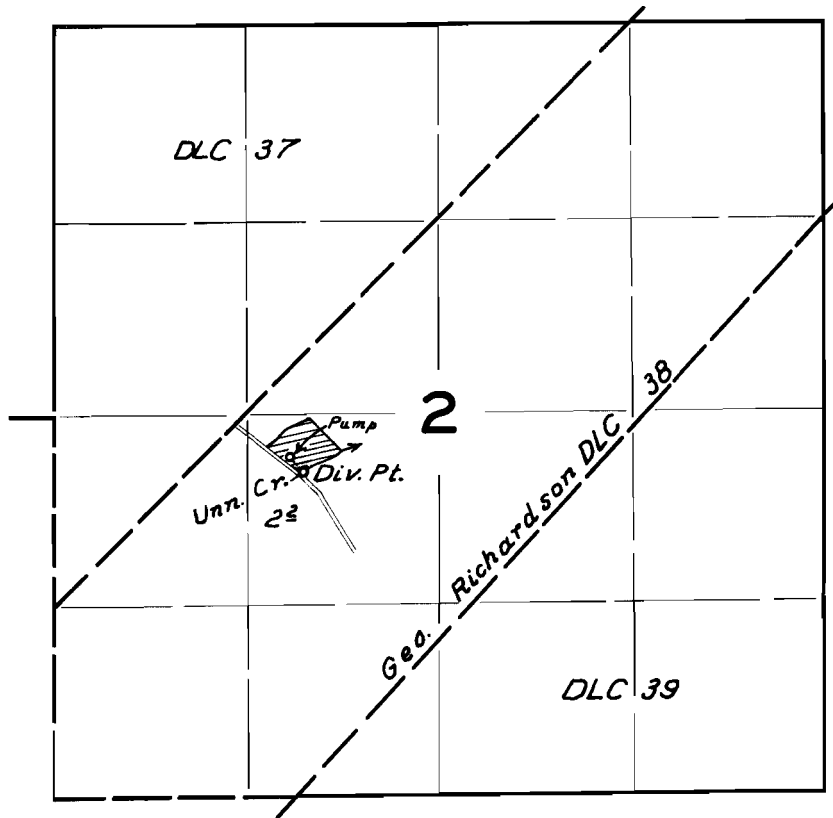

FINAL PROOF SURVEY
UNDER

Application No. *31053* Permit No. *24457*
IN NAME OF

T.G. & Ruth E. Lawson

Surveyed *Sept. 15* 19*59*, by *C.O. Bartels*