


T. 2S. R. 44E. W.M.

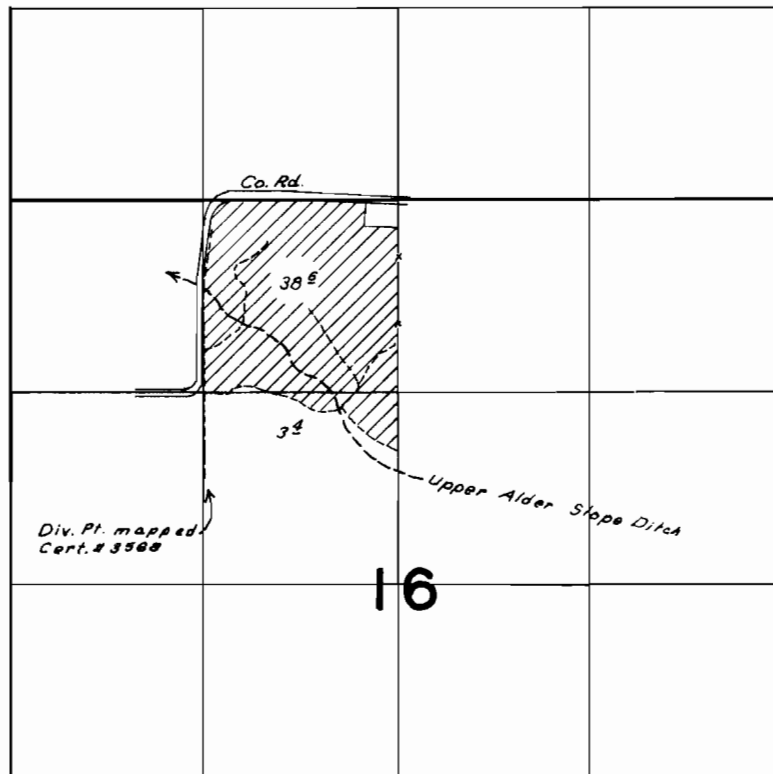

**FINAL PROOF SURVEY**  
UNDER

Application No. 30506 ... Permit No. 25065  
IN NAME OF

*Richard Brock*

Surveyed Aug. 13, 1959, by R.H. Jackson...