


T. 7S. R. 1W. W.M.

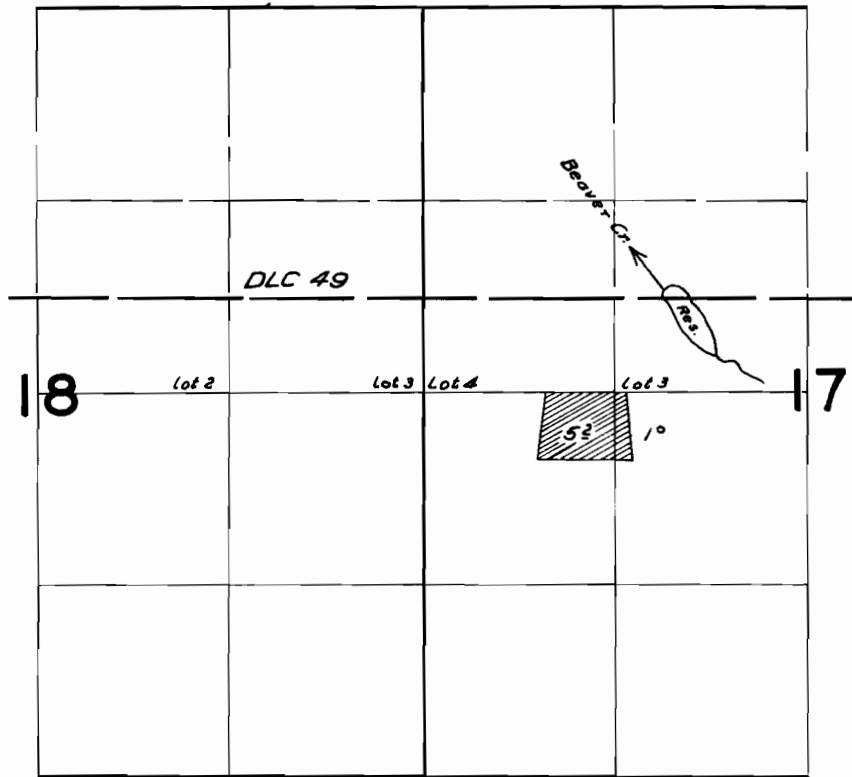

**FINAL PROOF SURVEY**  
UNDER

Application No. 31467 Permit No. 25069  
IN NAME OF

Paul Staedeli

Surveyed June 10 1959, by R. H. Jackson.