


T. 36 S. R. 6 W. W. M.

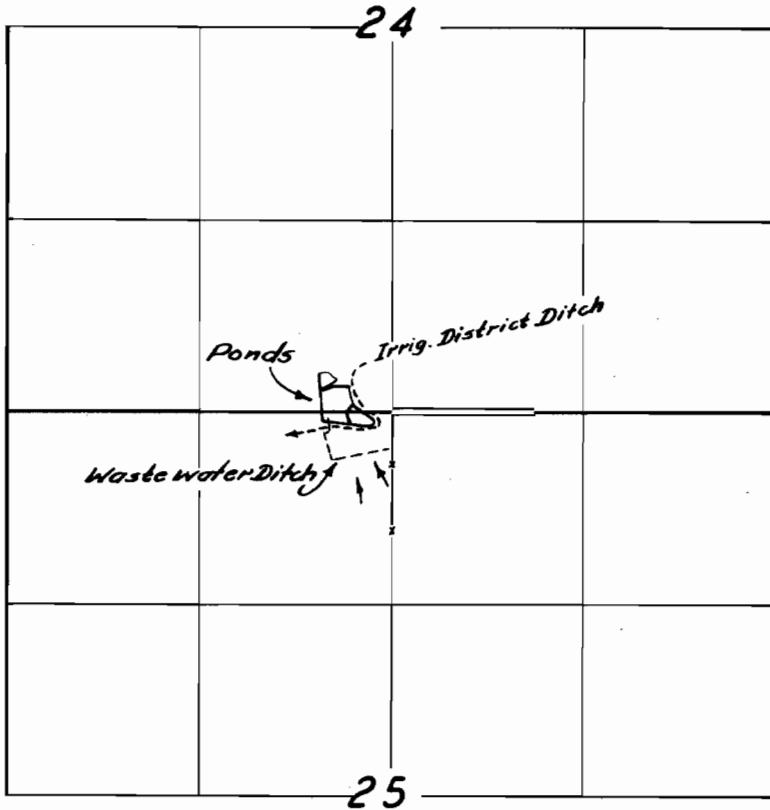

# FINAL PROOF SURVEY

UNDER

Application No. R-31997 ~~32934~~ Permit No. R-2108 ~~25287~~

IN NAME OF

FRANK SCHUTZWOHL

Surveyed July 15, 1959, by C.O. Bartels