


T.5 S.R.2 E.W.M.

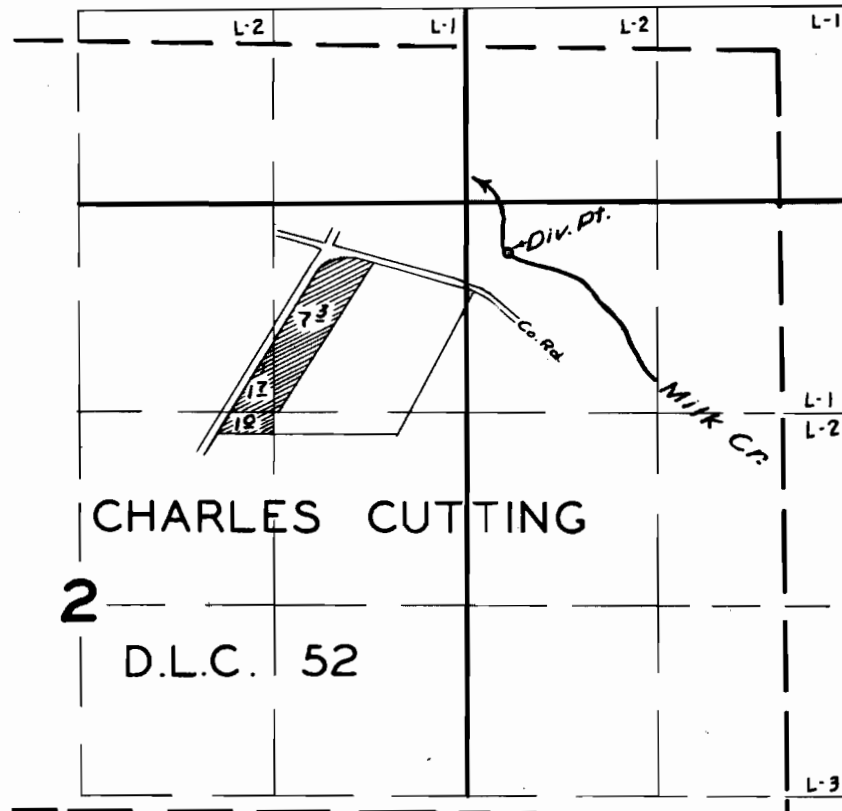

FINAL PROOF SURVEY
UNDER

Application No. 32203 Permit No. 25401
IN NAME OF

FRANK RUSSELL

Surveyed 28 April 1959, by M. Bish