T. 3 N. R. 9 & 10 W. W.M.

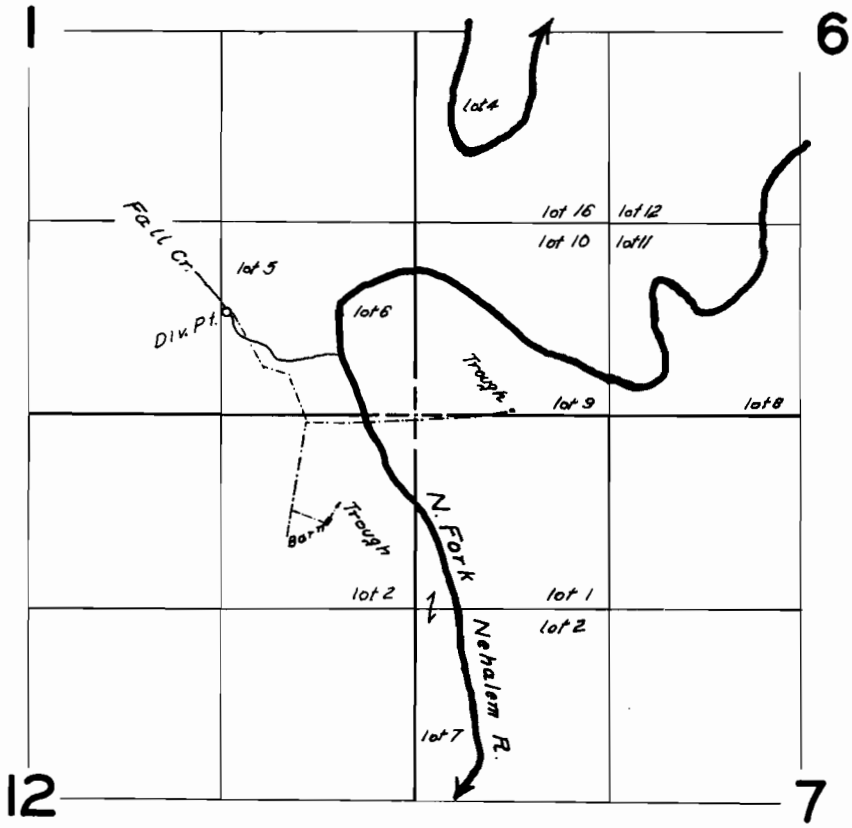

FINAL PROOF SURVEY
UNDER

Application No. 32296 Permit No. 25491
IN NAME OF

W. K. Scovell

Surveyed April 13 19 59, by R. H. Jackson

1957-U
1959-N