


T.10 S.R.1 W.W.M.

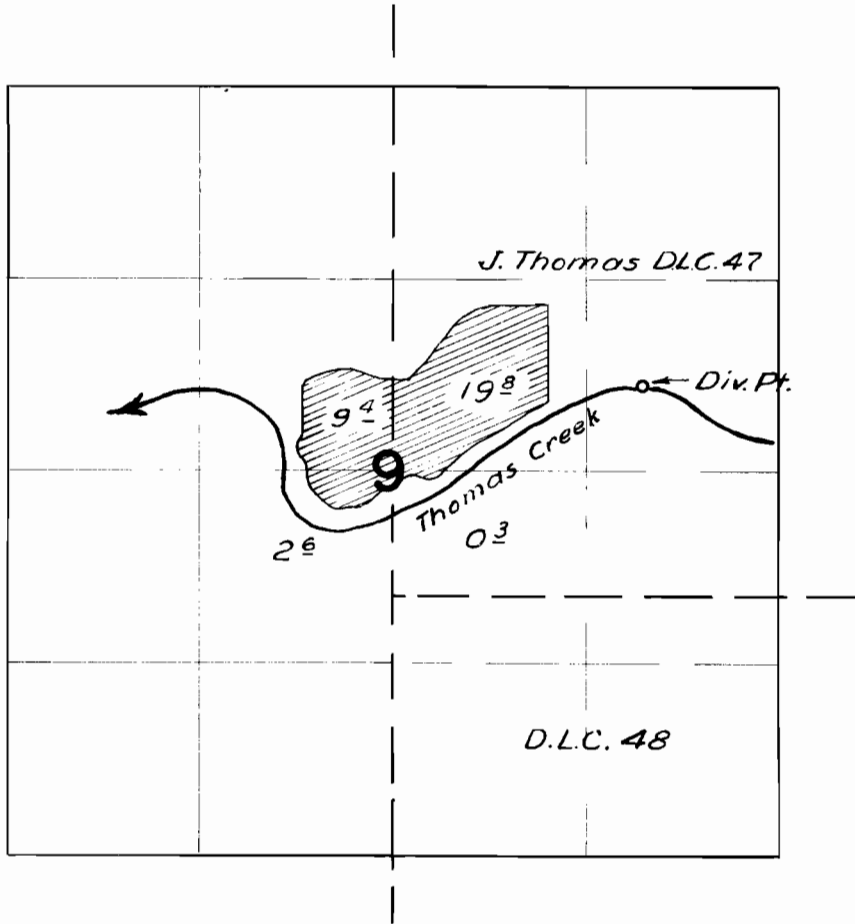

FINAL PROOF SURVEY UNDER

Application No. 32598. Permit No. 25724.
IN NAME OF

.....CAROL W. & SYLVIA E. CRENSHAW

Surveyed 2 July... 1959, by *m. Bish*