


T. 5S. R. 1W. W.M.

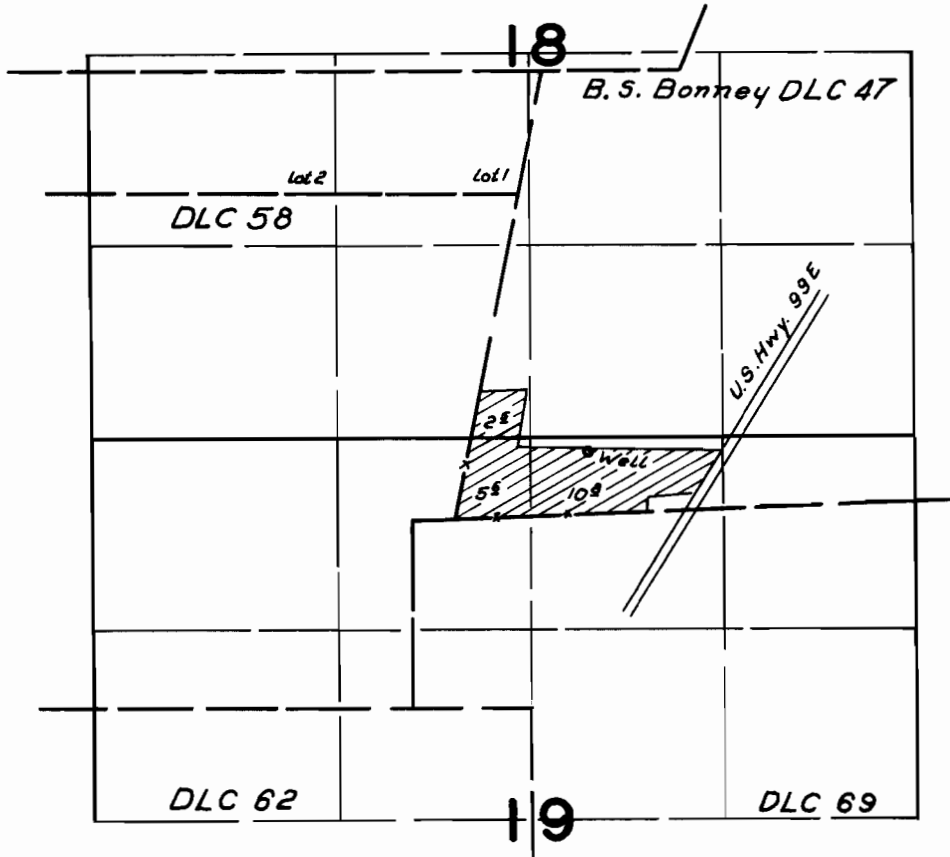

FINAL PROOF SURVEY
UNDER

Application No. *G99* Permit No. *G1*
IN NAME OF

William Stach

Surveyed *April 24 1959*, by *R. H. Jackson*