


T. 36S. R. 14E. W.M.

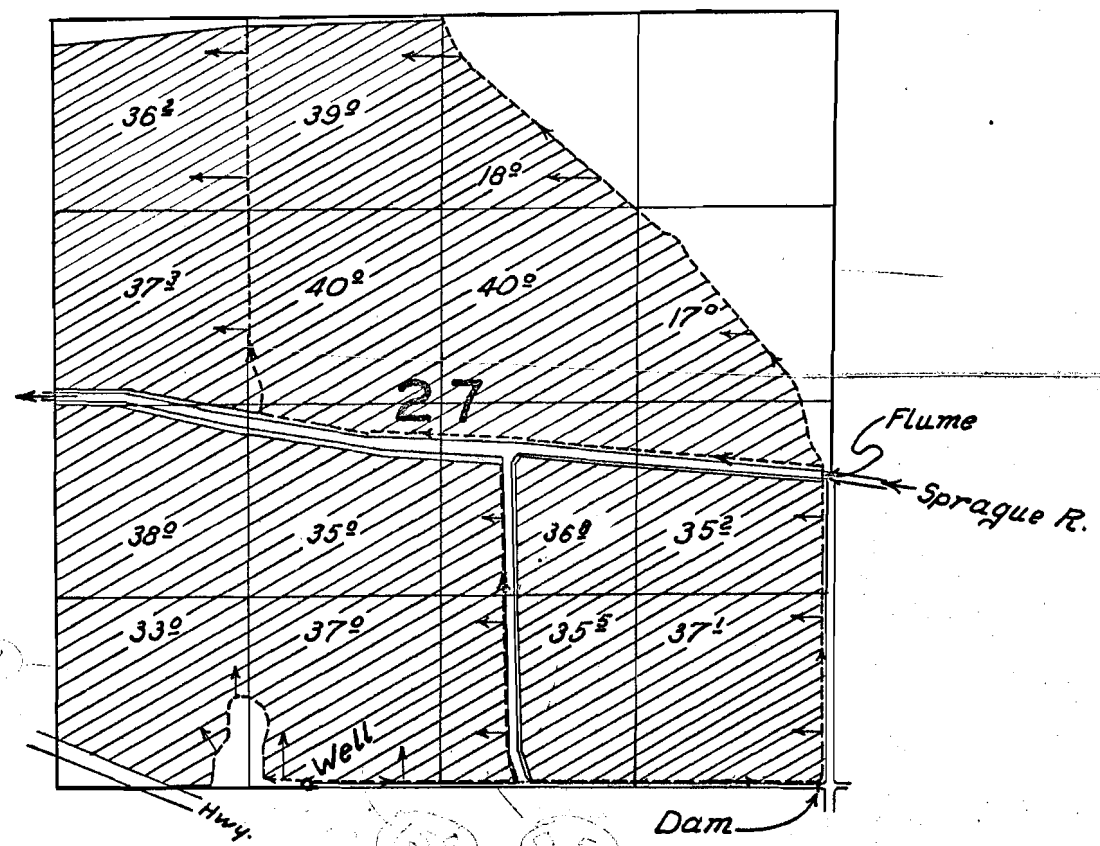

Dr. Sprague Co. Wells

FINAL PROOF SURVEY UNDER

Application No. G.145 Permit No. G.53
IN NAME OF

HENRY C. GERBER

Surveyed Oct. 14, 1959, by R. H. Jackson