


27101
75961
77025

T.27 S.R.16 E.W.M.

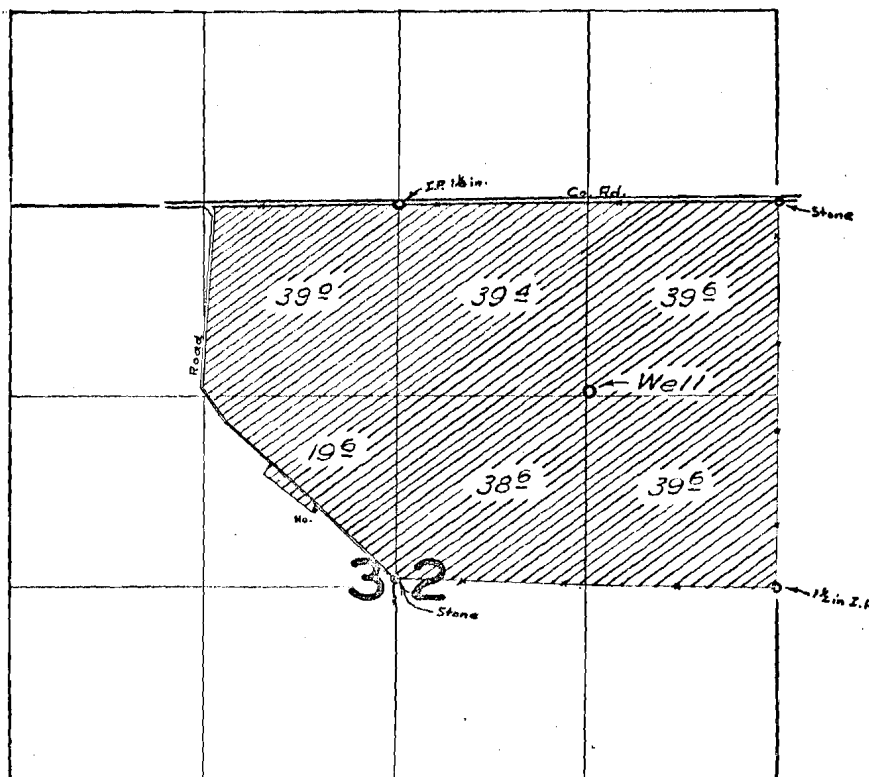

FINAL PROOF SURVEY UNDER

Application No. G-267... Permit No. G-172...
IN NAME OF

CLIFFORD L. & IRVIN C. ROBINSON

Surveyed 6 May 1959, by *W. B. Bish*