


# T. 14S. R. 39E. W.M.

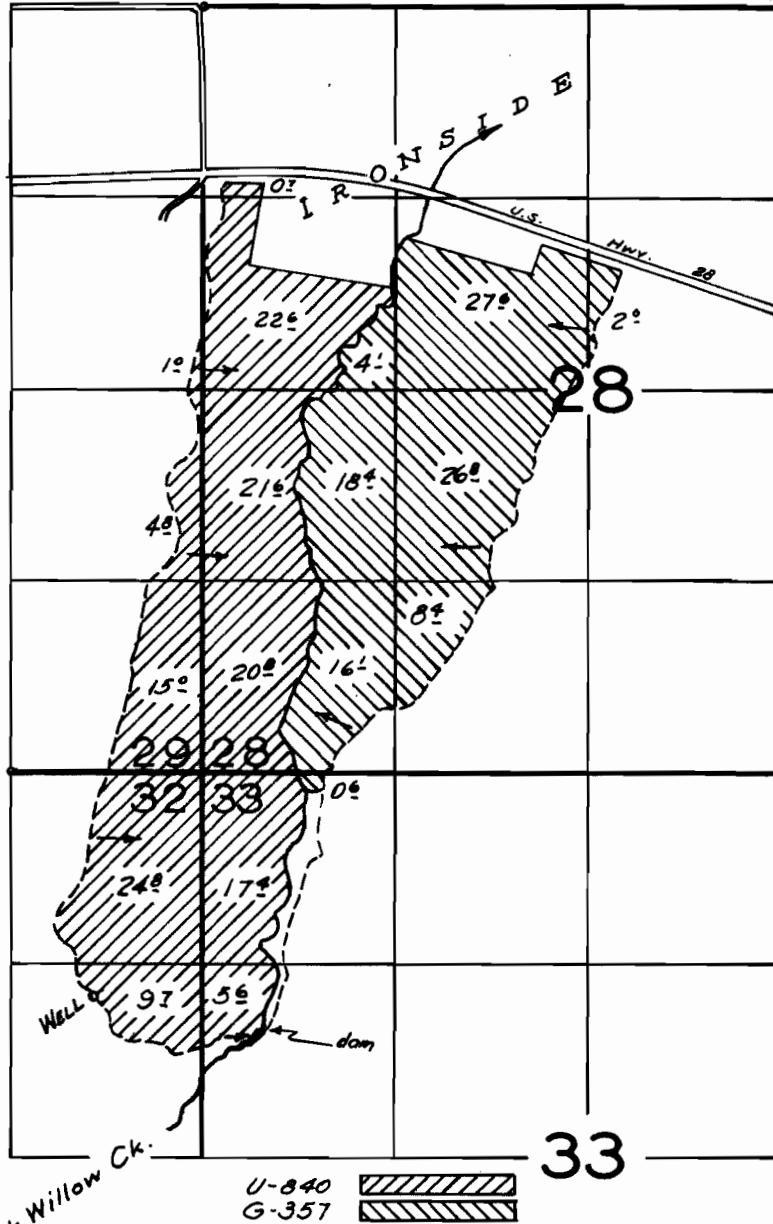

## FINAL PROOF SURVEY

UNDER

Application No. U-840 G-357 Permit No. U-733 G-243

IN NAME OF

RAY DUNCAN

Surveyed Sept. 25, 1959, by R. H. Jackson