


T.40S.R.12E.W.M.

East River Wells

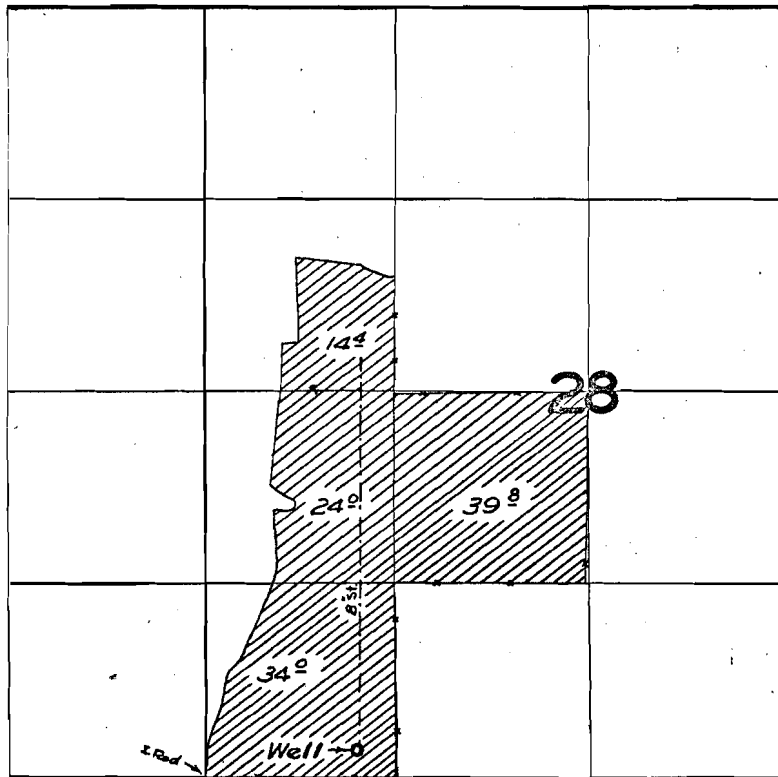

FINAL PROOF SURVEY

UNDER

Application No. 6-379 Permit No. 6-255

IN NAME OF

ALICE PEREIRA

Surveyed 21 Oct. 1959, by T. B. Smith