


T. 18 S. R. 46 E. W. M..

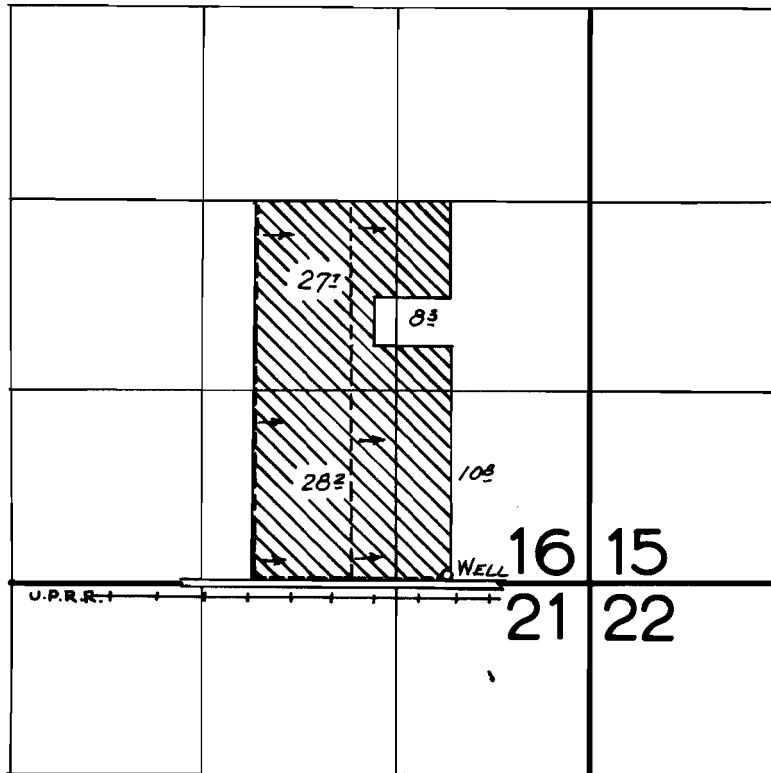

FINAL PROOF SURVEY
UNDER

Application No. G-391 Permit No. G-390
IN NAME OF

J.A. McNULTY & SON

Surveyed Sept. 18 1959 by *R. Jackson*