


T.13S. R.14E. W.M.

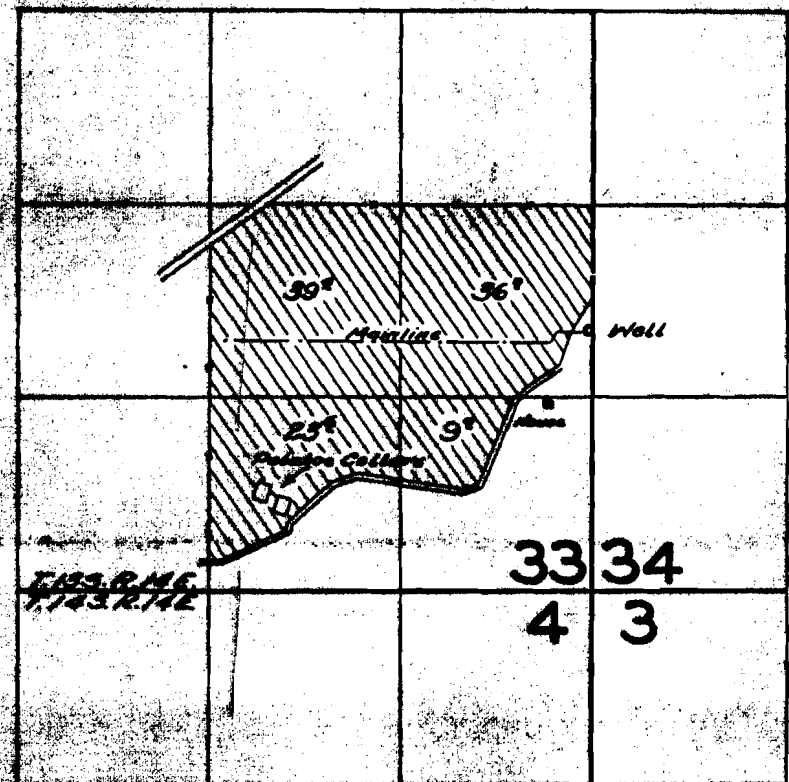

FINAL PROOF SURVEY UNDER

Application No. G-325 Permit No. G-442
IN NAME OF

BUCKNER BROS

Surveyed June 19 1939 by B.O. Baile