


16-491

27108
31167

T. 36S. R. 12E. W.M

Sprague Riv. wells

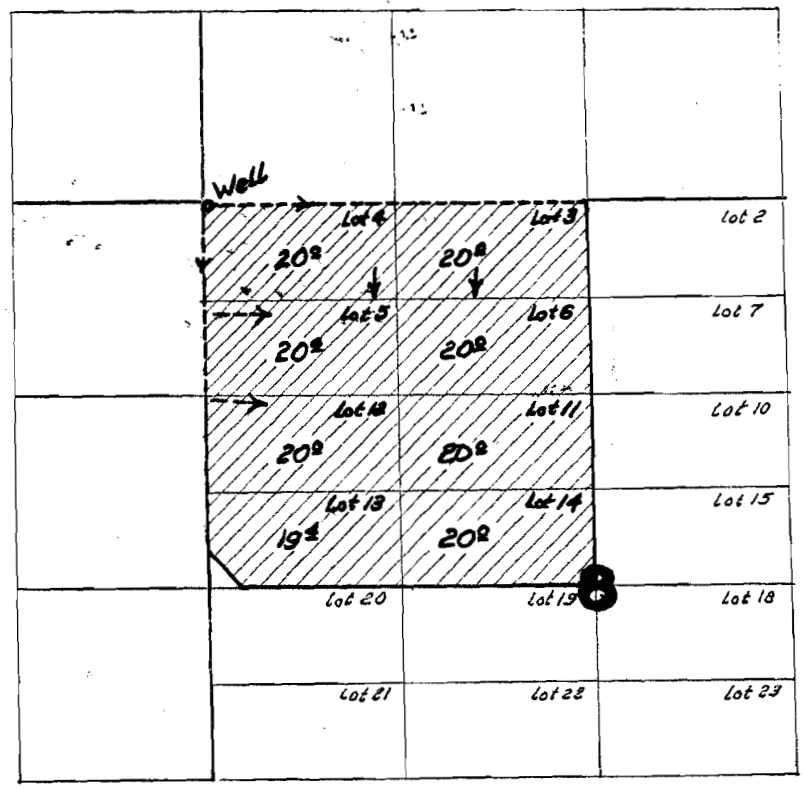

FINAL PROOF SURVEY

UNDER

Application No. **6571** Permit No. **6491**

IN NAME OF

Albert Byron Ross

Surveyed Oct. 23rd 59 by R. H. Jackson