


# T. 7S. R. 1W. W.M.

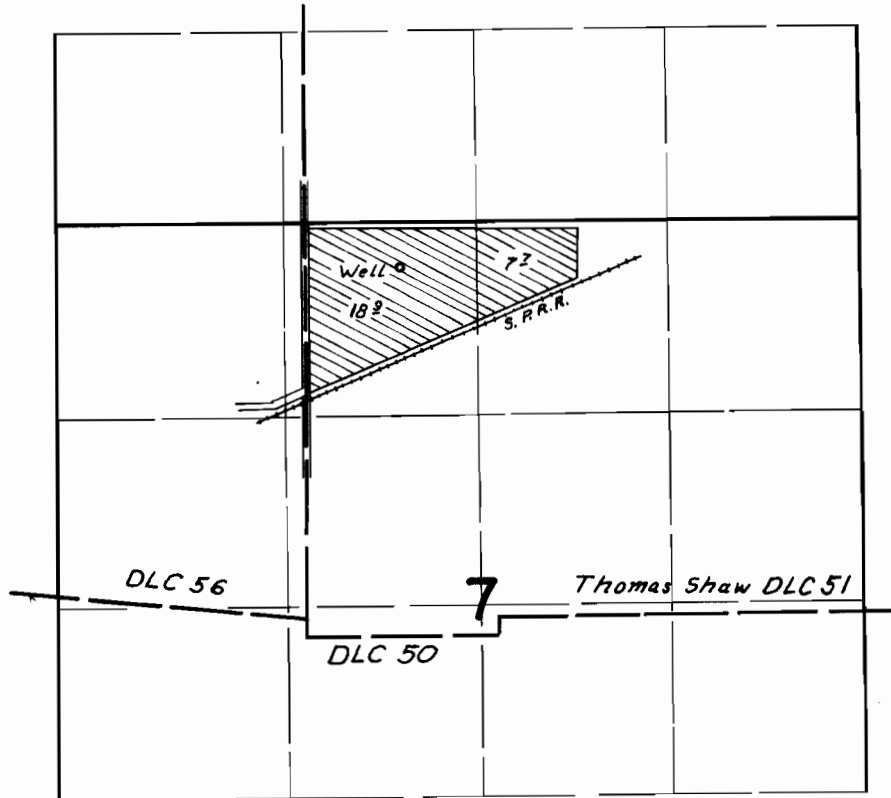

## FINAL PROOF SURVEY UNDER

Application No. *6618* Permit No. *6515*  
IN NAME OF

*Dettwyler / Schmidgall Dairy*

Surveyed *June 10, 1959*, by *R.H. Jackson*