


T. 7S. R. 2W. W.M.

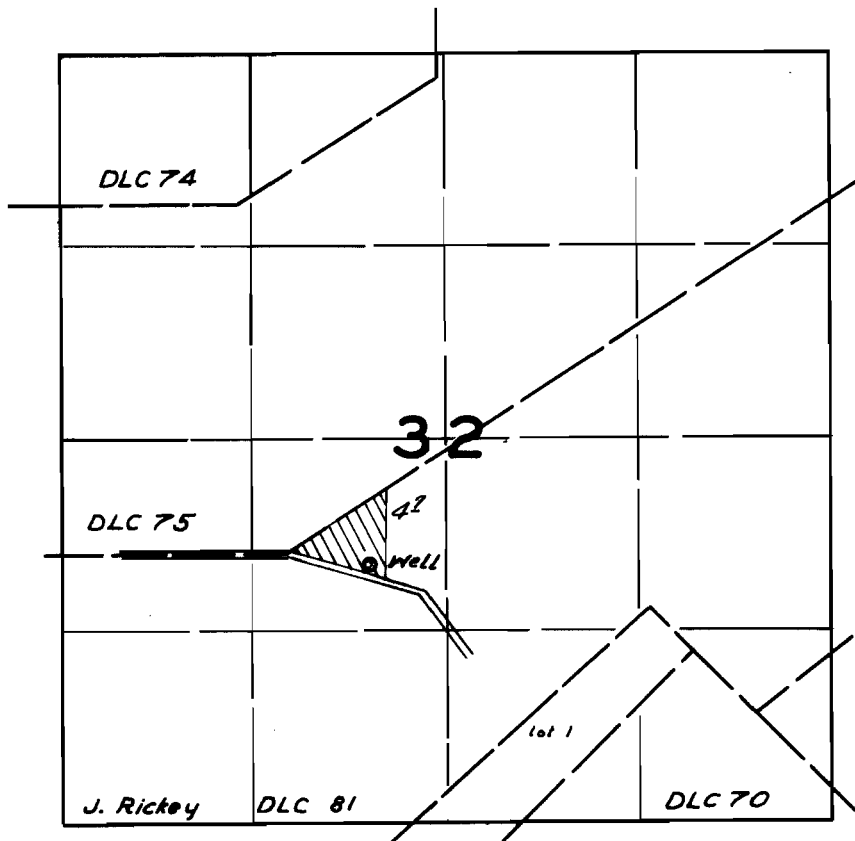

FINAL PROOF SURVEY
UNDER

Application No. *G.891* Permit No. *G.779*
IN NAME OF

Keith & Evelyn Mallory

Surveyed *June 9* 19*59*, by *R. H. Jackson*