


T.18S.R.47E.W.M.

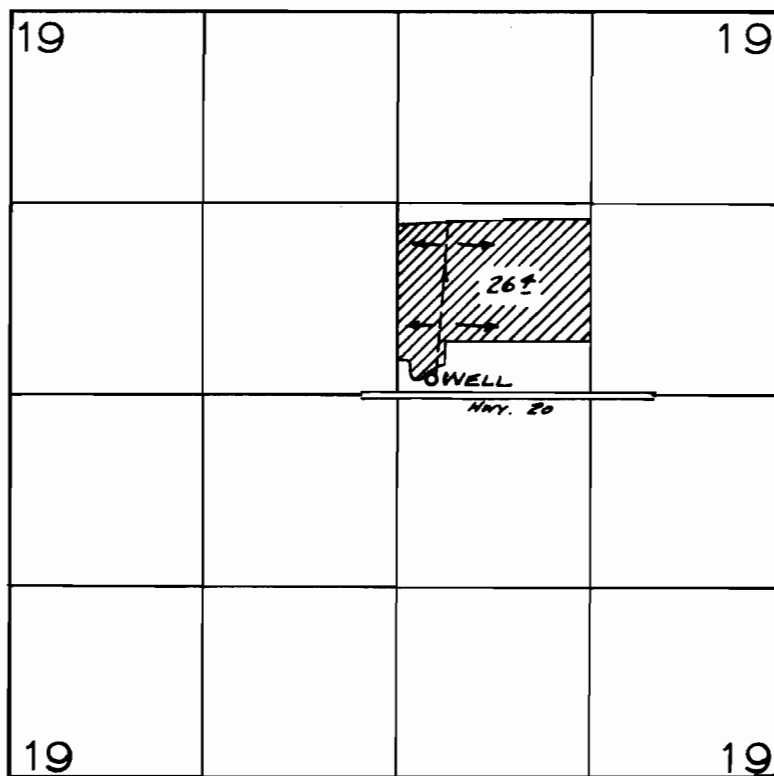

FINAL PROOF SURVEY
UNDER

Application No. G-1193 Permit No. G-1000
IN NAME OF

EARL M. & ADA WINEGAR

Surveyed Sept. 26 1959, by R. Jackson