


T. 7S. R. 2 W.W.M.

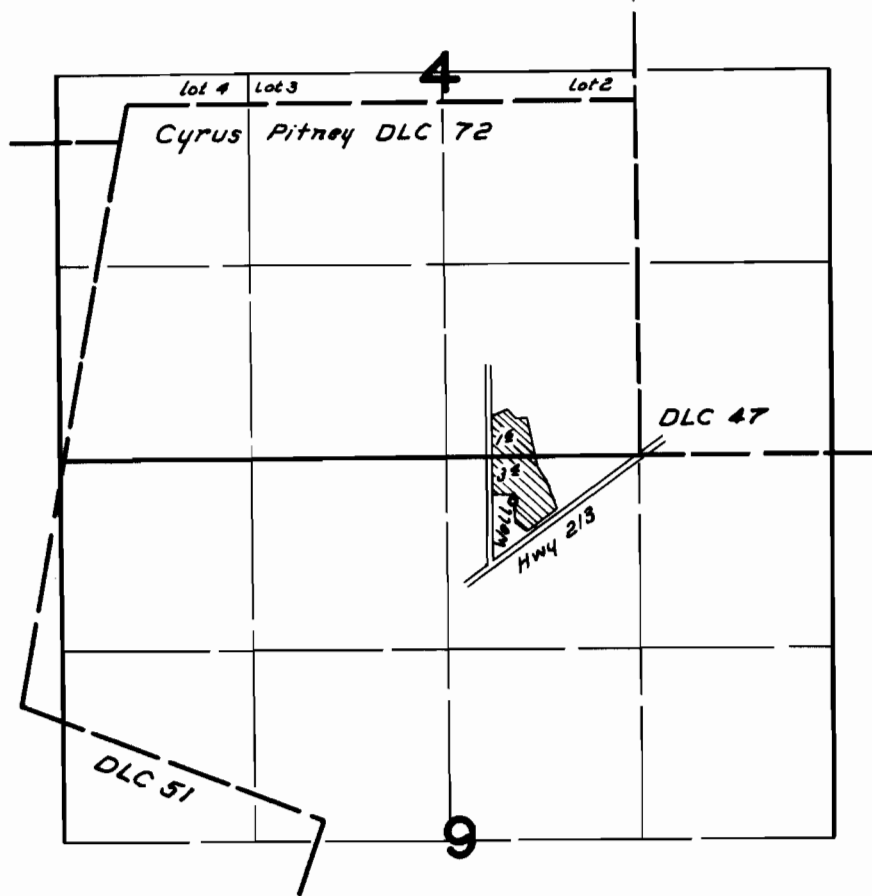

**FINAL PROOF SURVEY**  
UNDER

Application No. *G1145* Permit No. *G1052*  
IN NAME OF

*Emory J. Goode*

Surveyed *June 8* 19*59*, by *R. H. Jackson*