


T. 2S. R. 38E. W.M.

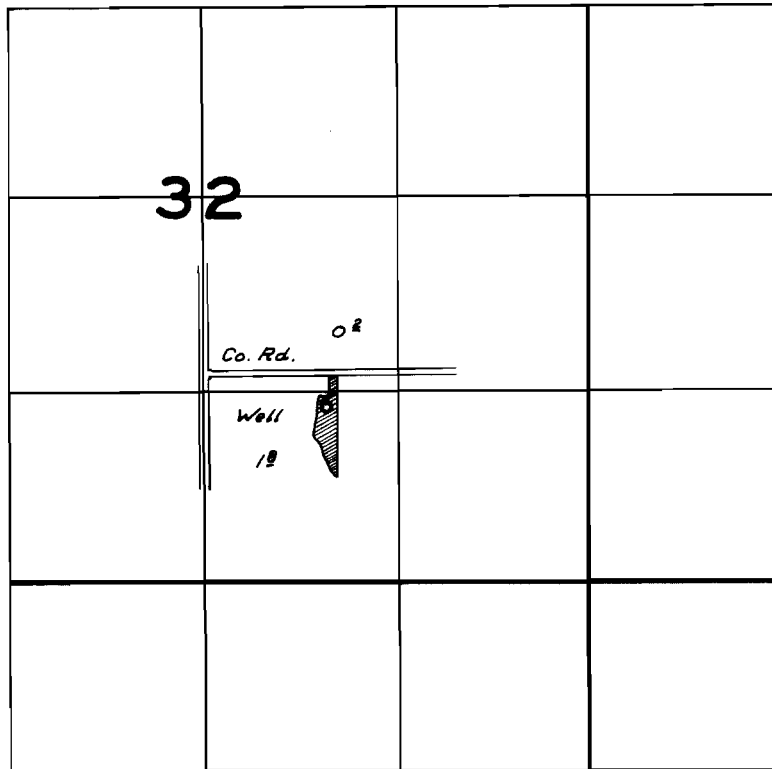

FINAL PROOF SURVEY
UNDER

Application No. *G1163* Permit No. *G1054*
IN NAME OF

A.L. and/or Lelah Voelz

Surveyed *Aug. 14, 1959*, by *R. H. Jackson*