


T. 6 N. R. 35 E. W.M.

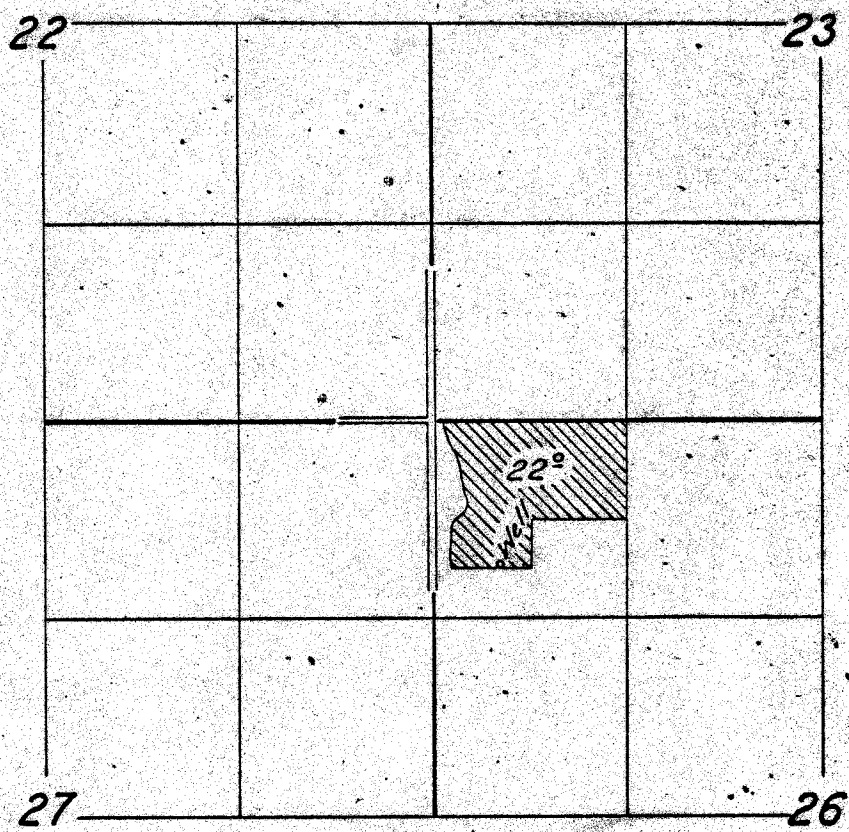

FINAL PROOF SURVEY

UNDER

Application No. G-1230 Permit No. G-1072

IN NAME OF

Walter L. Powell Sr.

Surveyed Oct. 21, 1959, by C. O. Barth