


T.18S.R.47E.W.M.

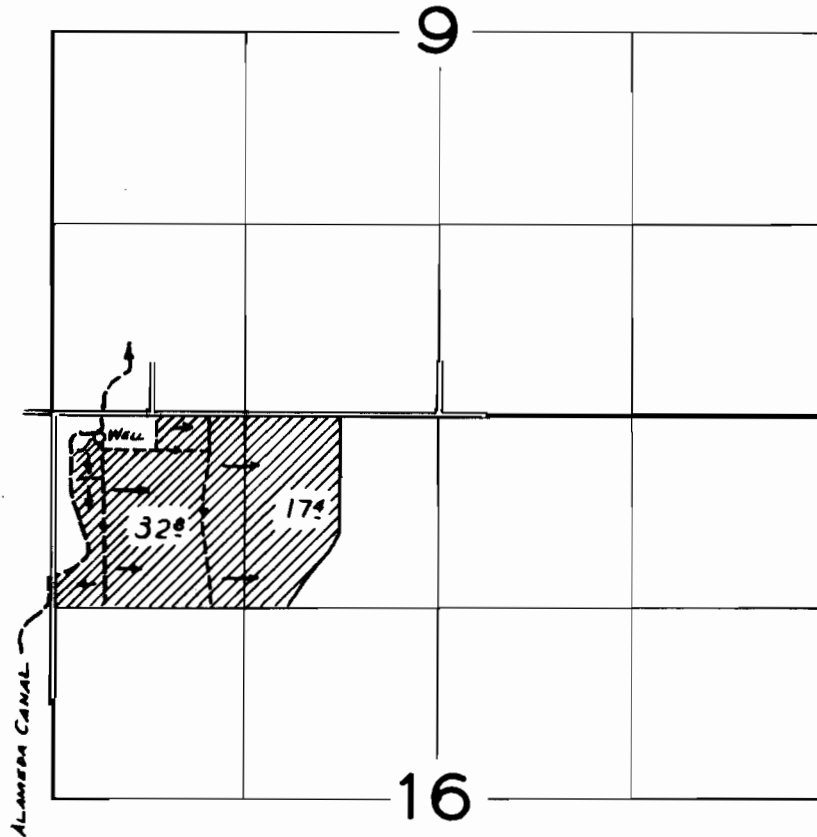

FINAL PROOF SURVEY
UNDER

Application No. G-892. Permit No. G-1145.
IN NAME OF

HARRY OKITA

Surveyed Sept. 17, 1959, by *R.H. Jackson*