


G-1266
27119

T.6 N. R. 35 E. W.M.

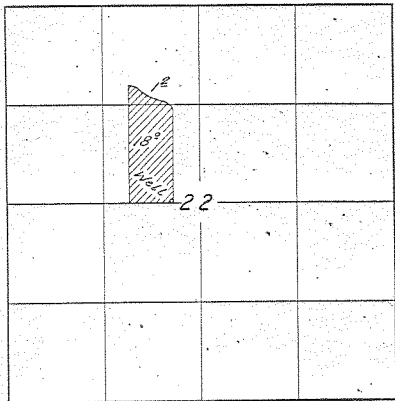

FINAL PROOF SURVEY

UNDER

Application No. G-1335 Permit No. G-1266

IN NAME OF

Thomas Fehrenbacher

Surveyed Oct. 23, 1959, by C.O. Butts