


T.6N.R.35E.W.M.

Washington

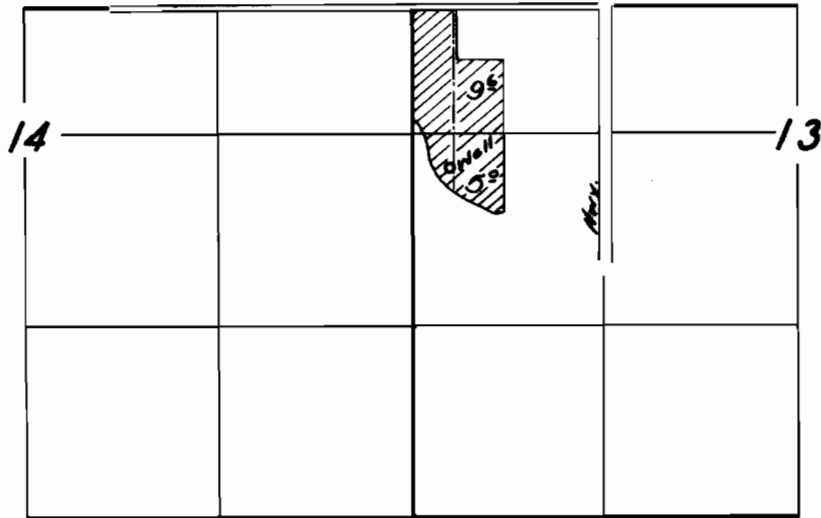

# FINAL PROOF SURVEY

UNDER

Application No. G-1488 Permit No. G-1360

IN NAME OF

William Bork

Surveyed Oct. 23 19 59, by C. O. Burtis