


27122 U-266  
27121 U-220

# T.39 S.R.11 1/2 E.W.M.


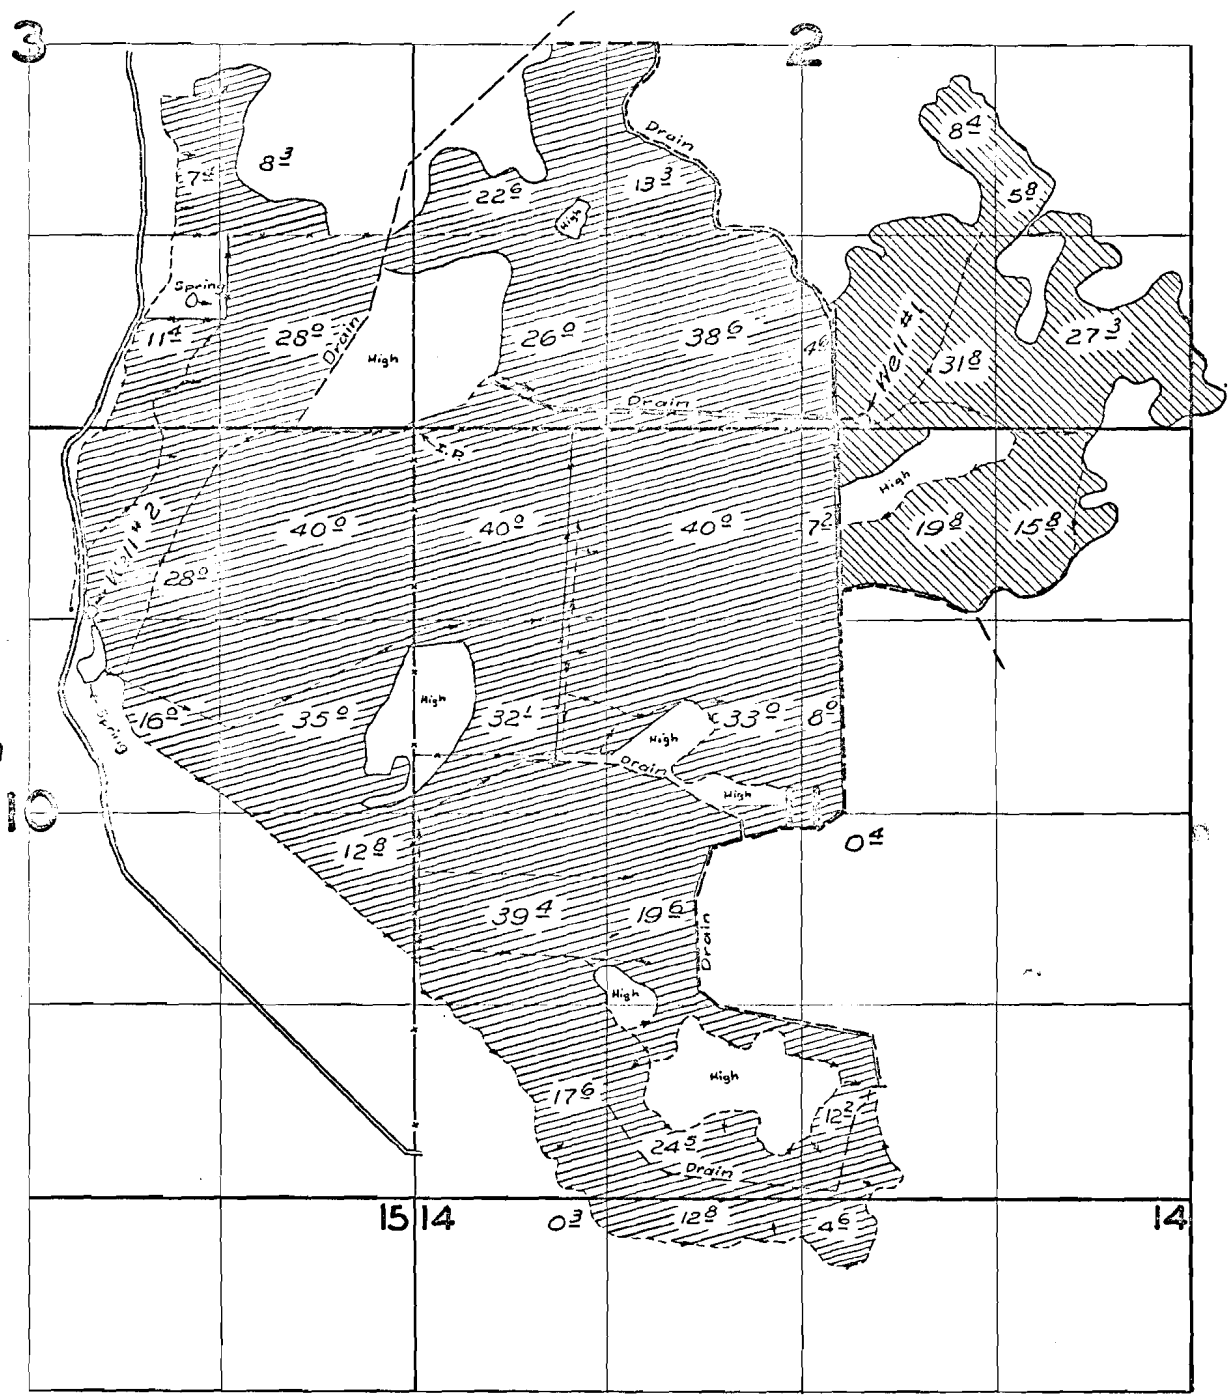

## FINAL PROOF SURVEY

ORDER

Application No. U-246 ... Permit No. U-220  
U-293 ... Permit No. U-266

IN NAME OF

L. J. HORTON & ANNE S. HORTON

Surveyed 16 Oct. 19 59., by M. Bush