


T.6 N. R. 35 E. W.M.

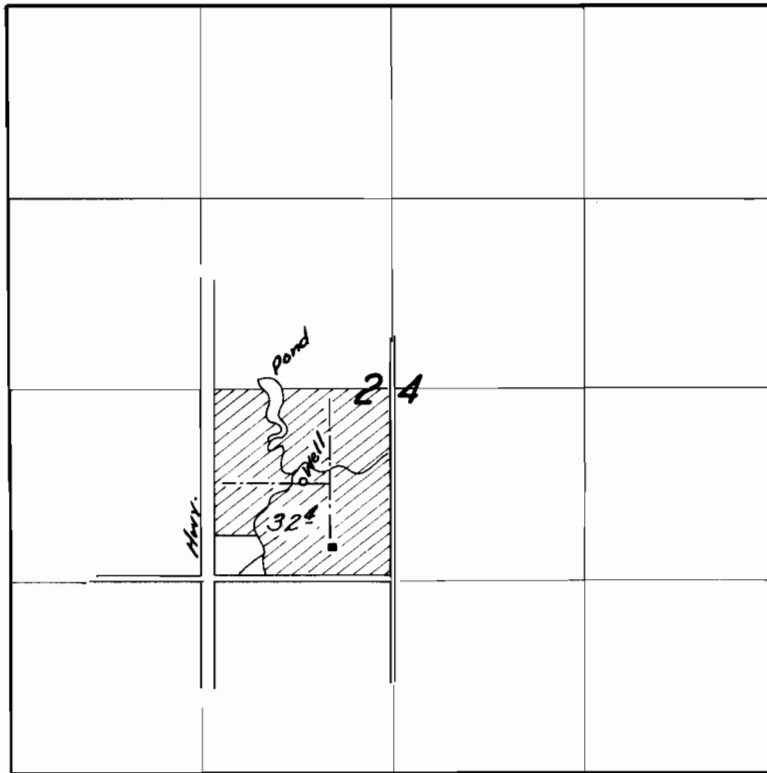

FINAL PROOF SURVEY

UNDER

Application No. U-314 Permit No. U-288

IN NAME OF

Ralph R. Clark

Surveyed Oct 26 1959, by C. O. Baette