


U-395

C-27124

T.6N. R.36E. W.M.

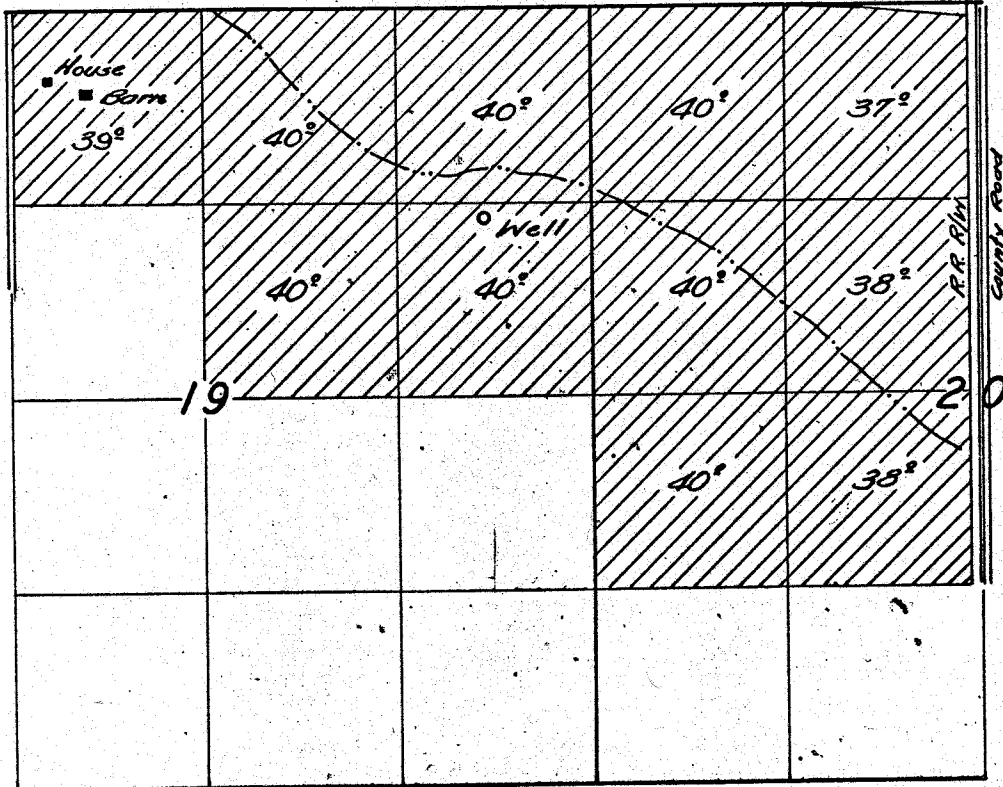

FINAL PROOF SURVEY

UNDER

Application No. U-427 Permit No. U-395

IN NAME OF

Walter G & Pearl R. Cowan

Surveyed Oct. 26, 1959, by C.O. Smith