


U-628  
C-27126

T.6 N. R. 35 E. W.M.

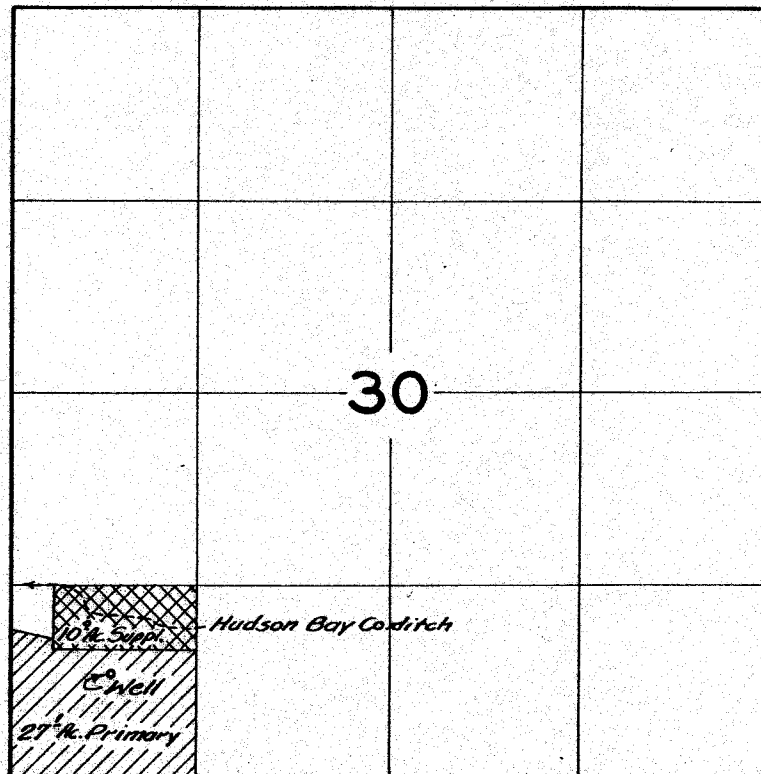

FINAL PROOF SURVEY

UNDER

Application No. U-684 Permit No. U-628

IN NAME OF

Cecil Hankla

Surveyed Oct. 27, 1959, by A. O. Baetels

NZ-5F-59