


U-647

T. 1N. R. 12E. W.M

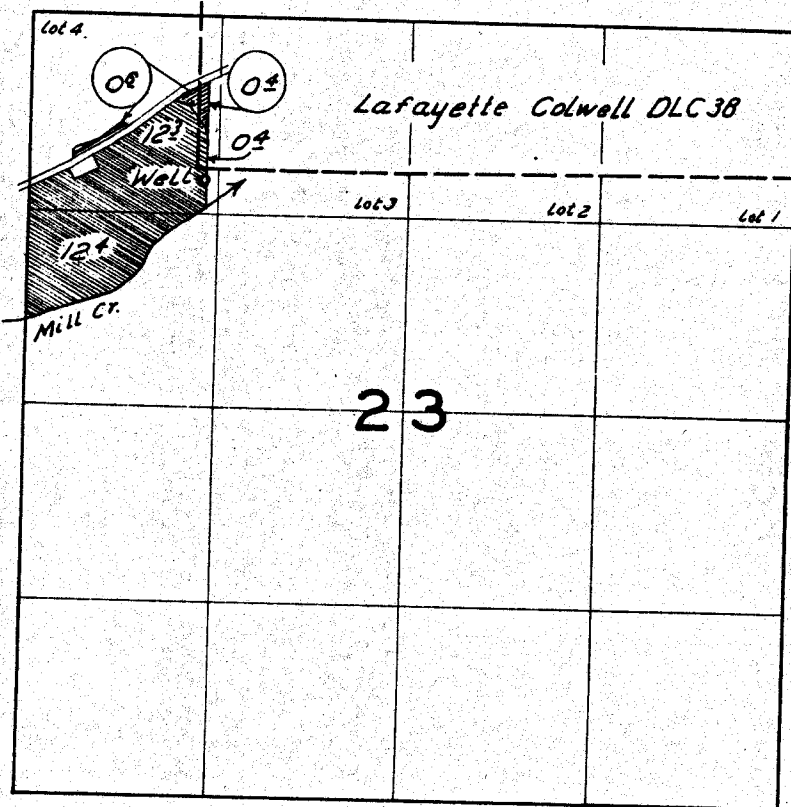

Suppl.  Primary 

FINAL PROOF SURVEY UNDER

Application No. *U732*..... Permit No. *U647*.....
IN NAME OF

Paul M. & Geraldine L. Martin.....

Surveyed Nov. *11/12* 1959, by *R. H. Jackson*.....