


T. 29S. R. 14 W. W.M.

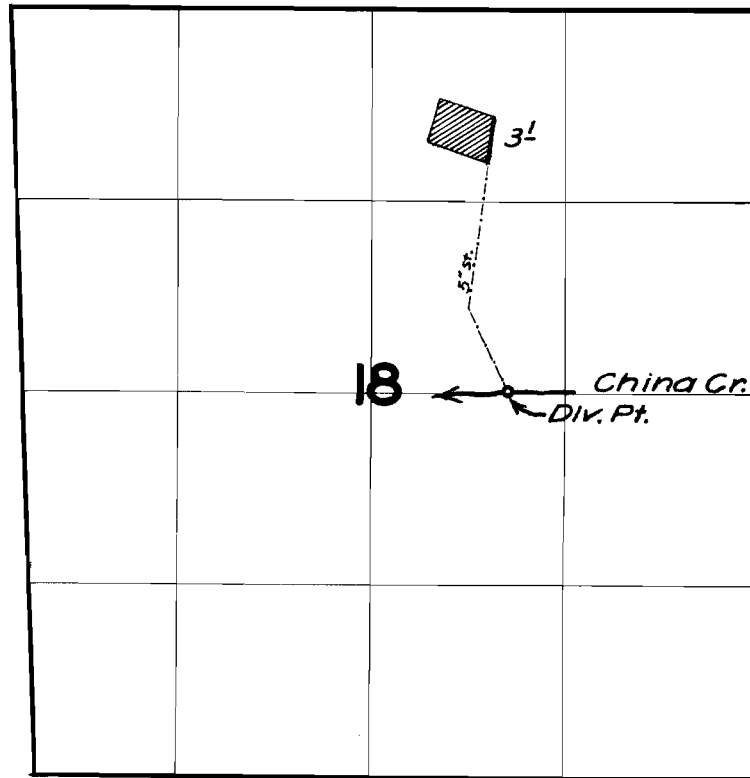

FINAL PROOF SURVEY
UNDER

Application No. 22201 Permit No. 17535
IN NAME OF

George E. & Viola Dawn DeOs

Surveyed 19 April 1958, by Tom Bish