


T.13 & 14 S., R.10 W. W.M.

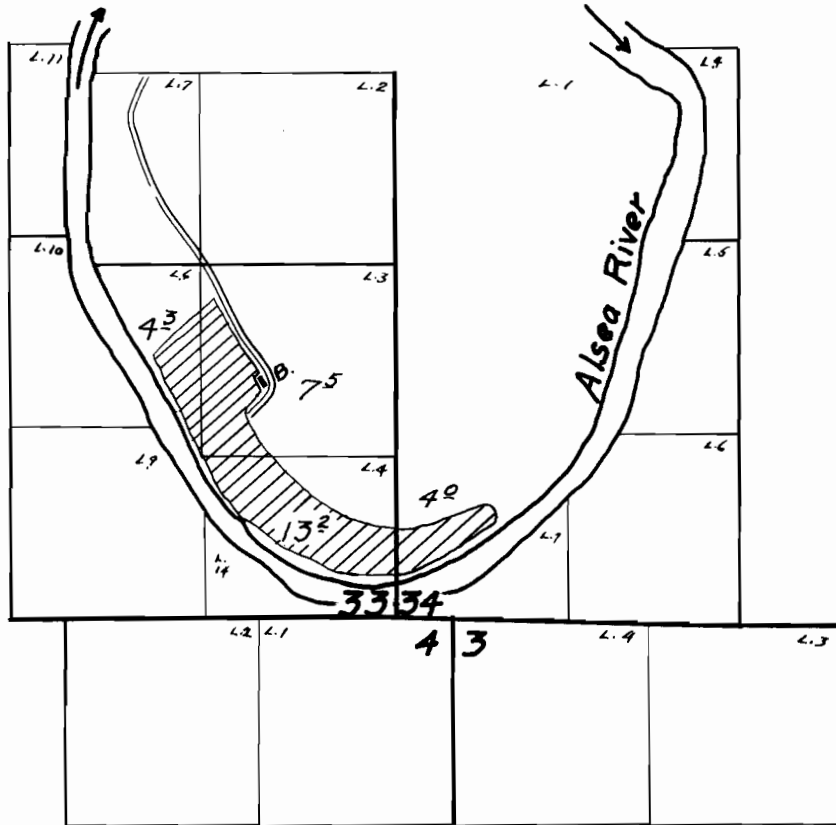

## FINAL PROOF SURVEY

UNDER

Application No. 22634 Permit No. 17882

IN NAME OF

G. E. Paulson

Surveyed 18 April 1953, by H. L. Coffman