


T. 5N. R. 9W. W.M.

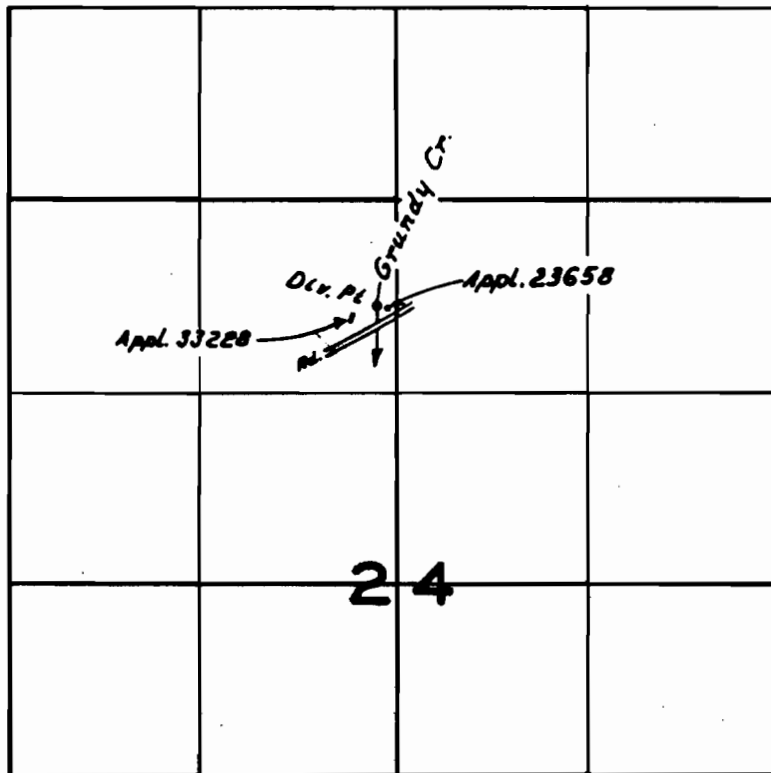

FINAL PROOF SURVEY
UNDER

Application No. ³³²²⁸ ~~23658~~ Permit No. ²⁶²⁸⁰ ~~18701~~.....
IN NAME OF

.....*George & Donna Ordway*.....

Surveyed *June 30 1959*, by *G.O. Bartels*.....