


T. 1N. R. 39E. W.M.

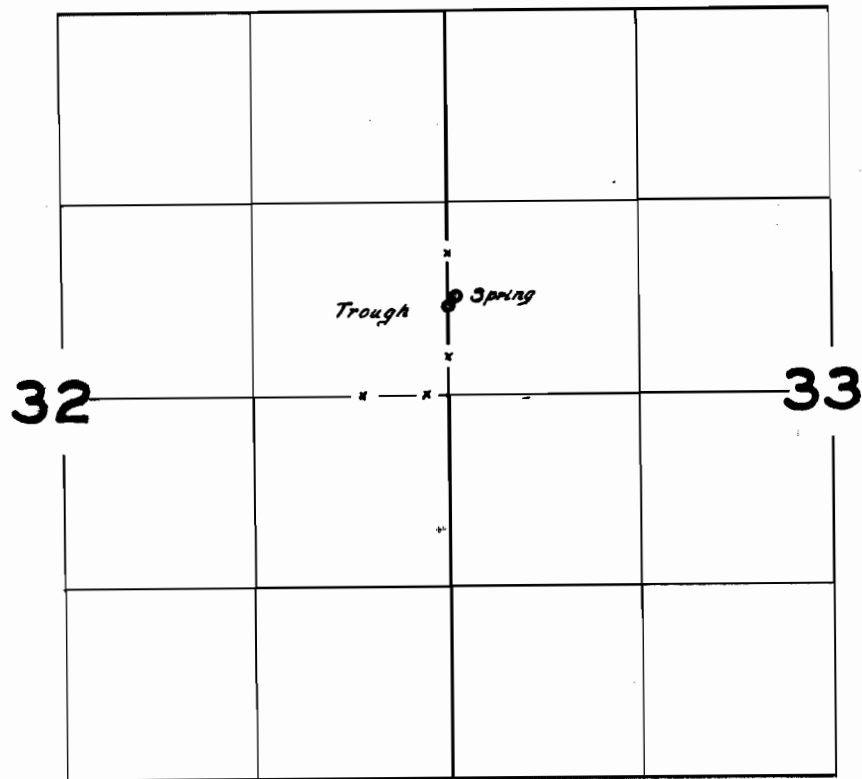

FINAL PROOF SURVEY
UNDER

Application No. 23709 Permit No. 18808
IN NAME OF

Aileen McDonald & Margaret Works

Surveyed Aug 18, 1959, by R. H. Jackson