


T. 2S. R. 2W. W.M.

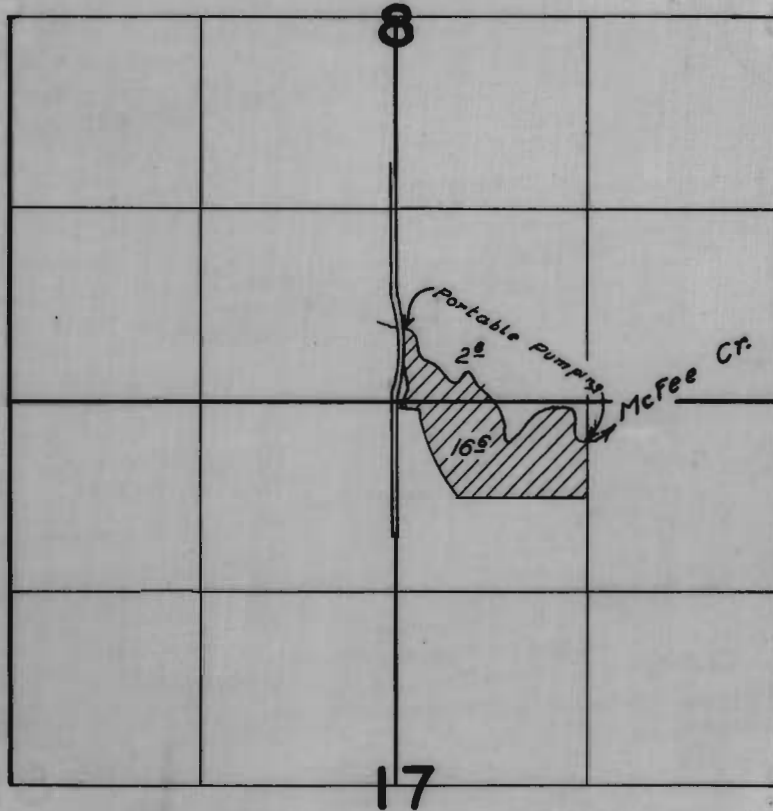

FINAL PROOF SURVEY

UNDER

Application No. 24749 Permit No. 19512

IN NAME OF

Robert Kvayle

Surveyed Sept. 17 1959, by C. O. Bartels