


T.18S. R. 45E.W.M.

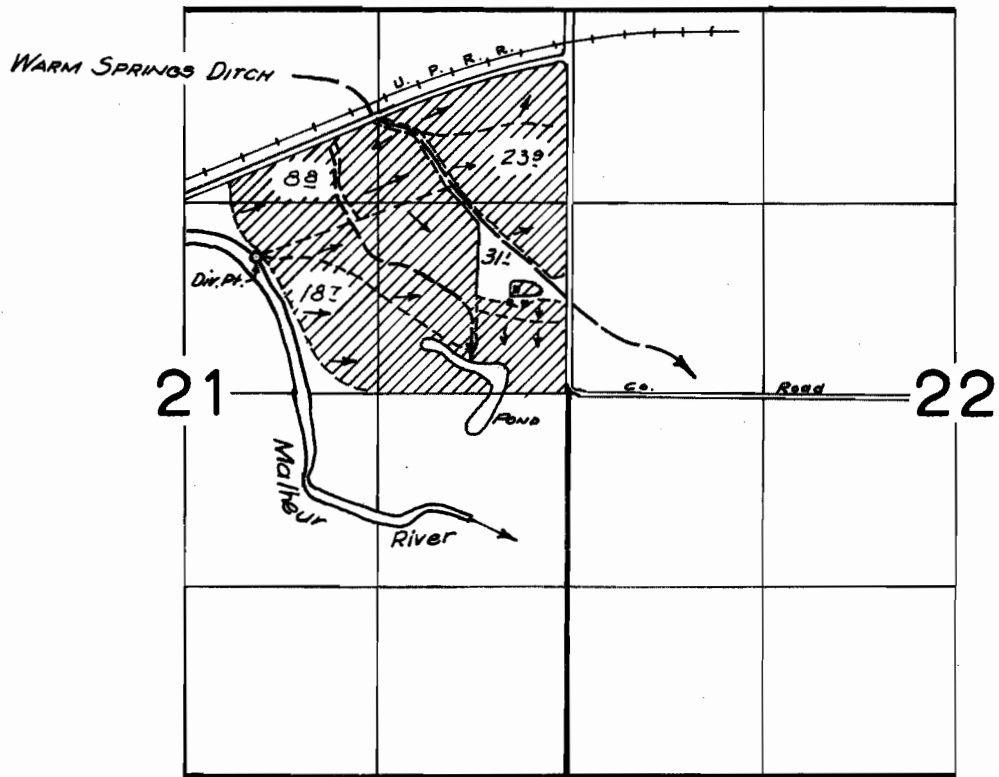

FINAL PROOF SURVEY

UNDER

Application No. 25387. Permit No. 19995

IN NAME OF

EDWIN & VIOLA M. JOHNSON

Surveyed Sept. 26 1959, by R.H. Jackson