


T.10 S.R.1 E.W.M.

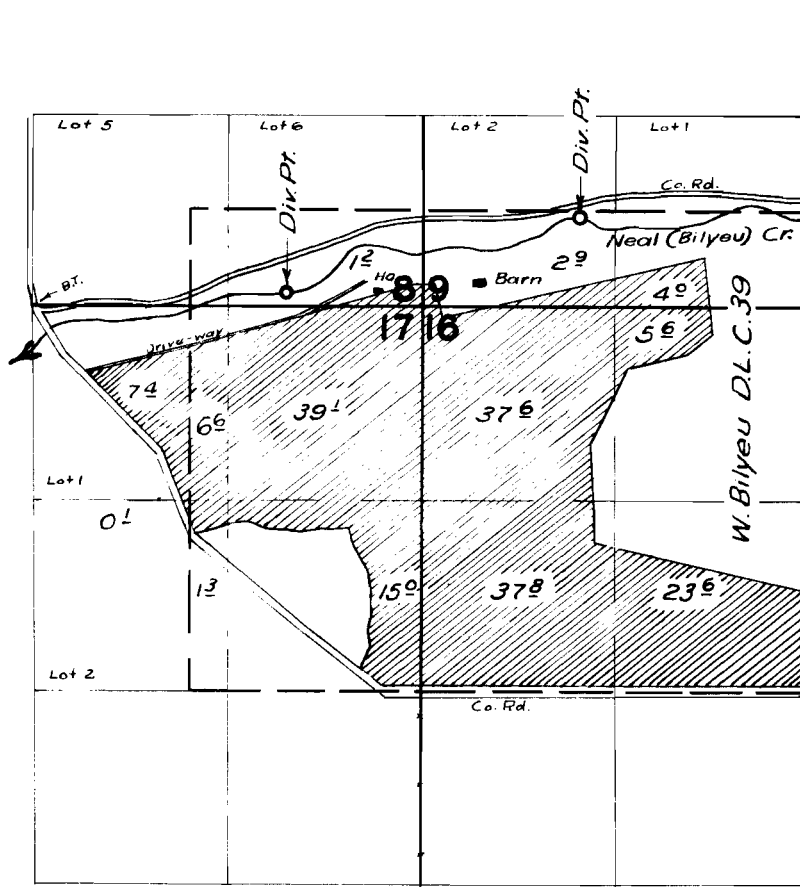

FINAL PROOF SURVEY UNDER

Application No. 25386 Permit No. 20215
IN NAME OF

KENNETH J., ANNE STEWARD, & BERNARD BENTZ

Surveyed 30 June 1959, by *M. Bish*