


T. 1 S. R. 38 E. W.M.

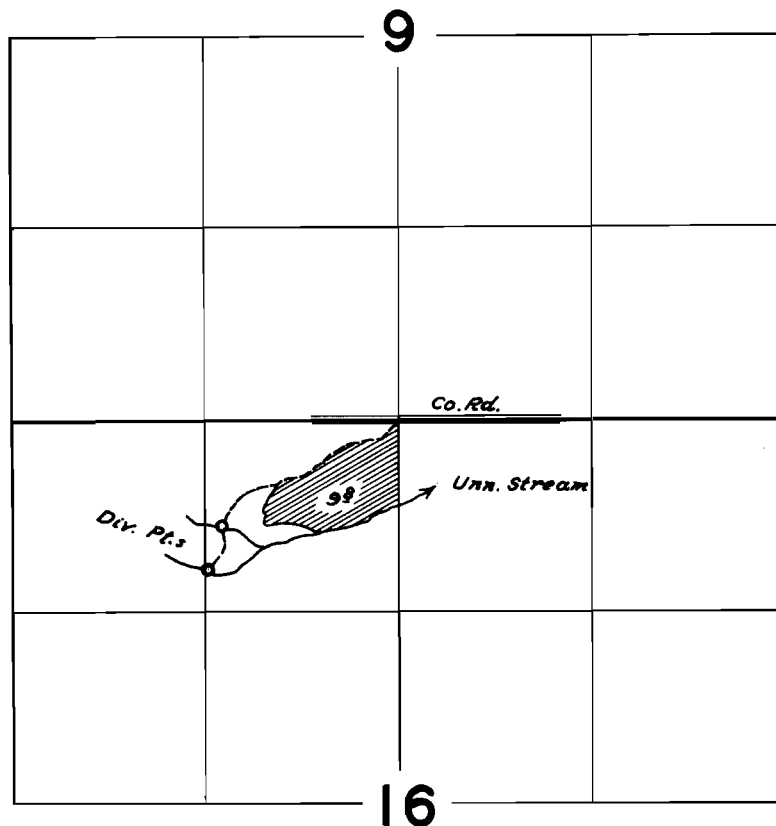

FINAL PROOF SURVEY
UNDER

Application No. 26165 Permit No. 20424
IN NAME OF

James H. & Eessie M. Wagoner

Surveyed Aug. 17, 1959, by R. H. Jackson