


T10S.R. 1 E.W.M.

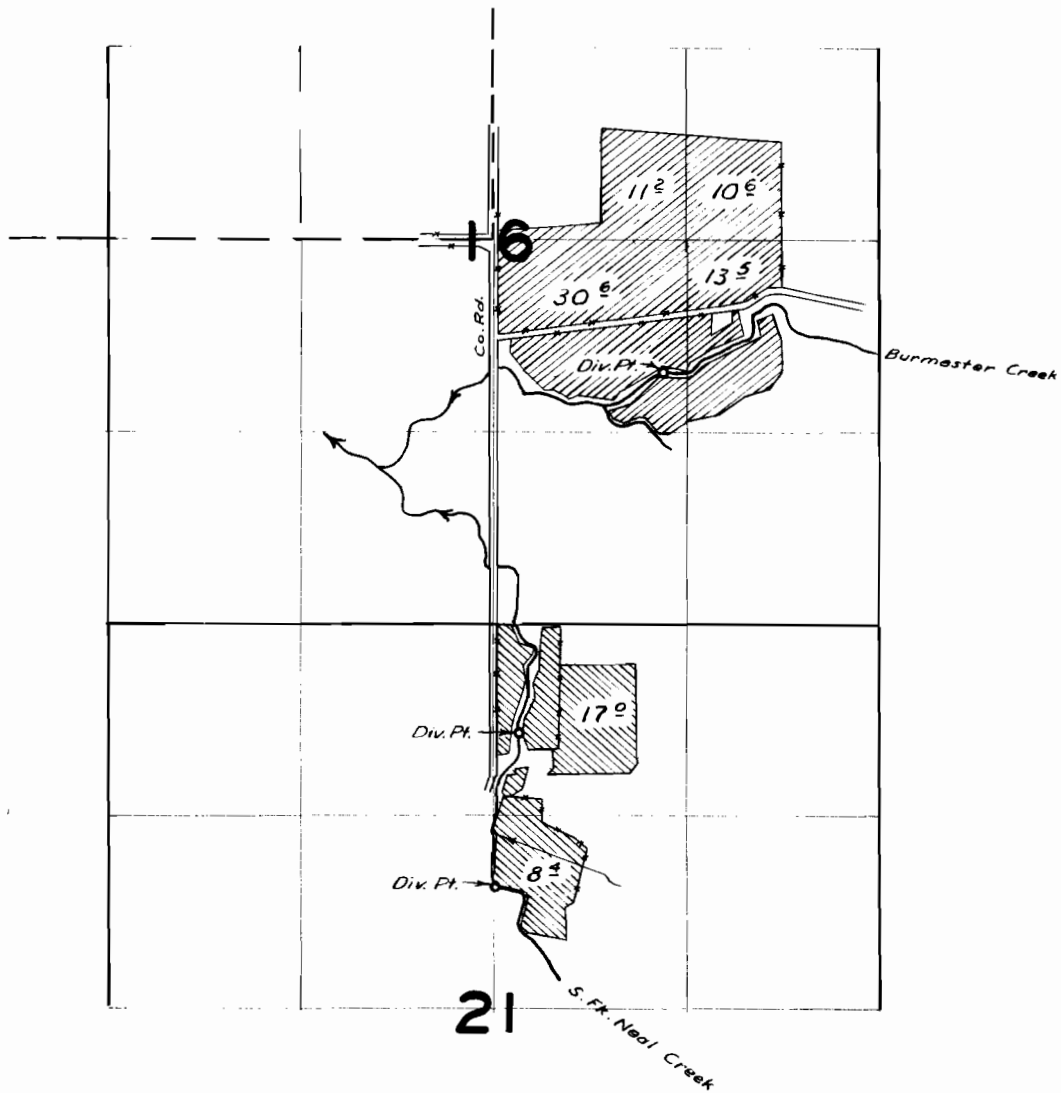

**FINAL PROOF SURVEY**  
UNDER

Application No. 26329 Permit No. 20458  
IN NAME OF

ELDRED R. & EMMA A. BURTON

Surveyed 2 July 1959, by *Tom Bick*