


T. 13S. R. 2E. W.M.

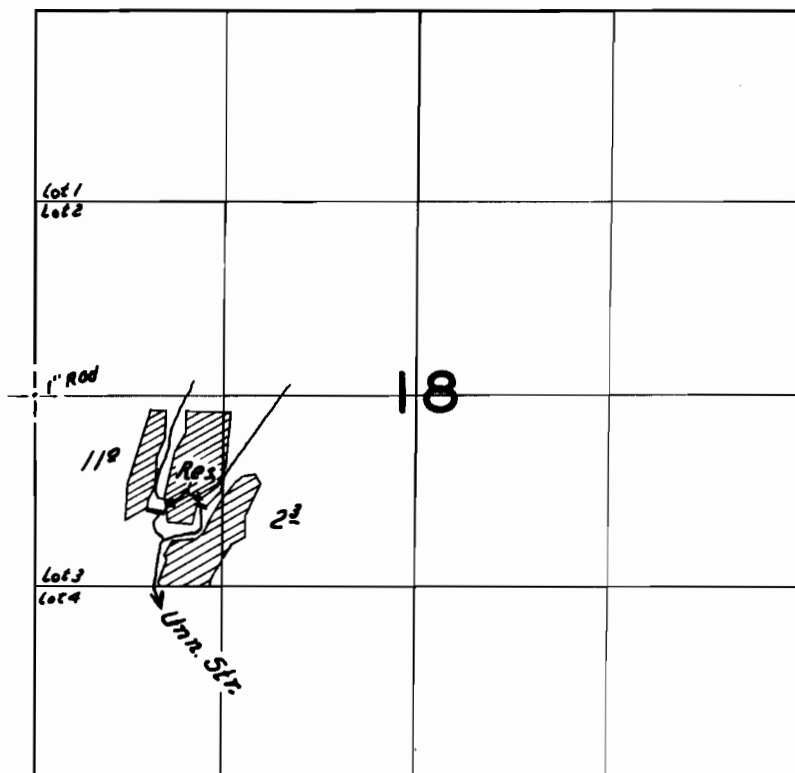

FINAL PROOF SURVEY

UNDER

R 23115

R 1180

Appl. for No. 23116 Filed Oct. 20 1959

IN HAND OF

Leo Polahn

Surveyed Aug. 28 1959, by R.H. Jackson