


T. 13S. R. 2E. W.M.

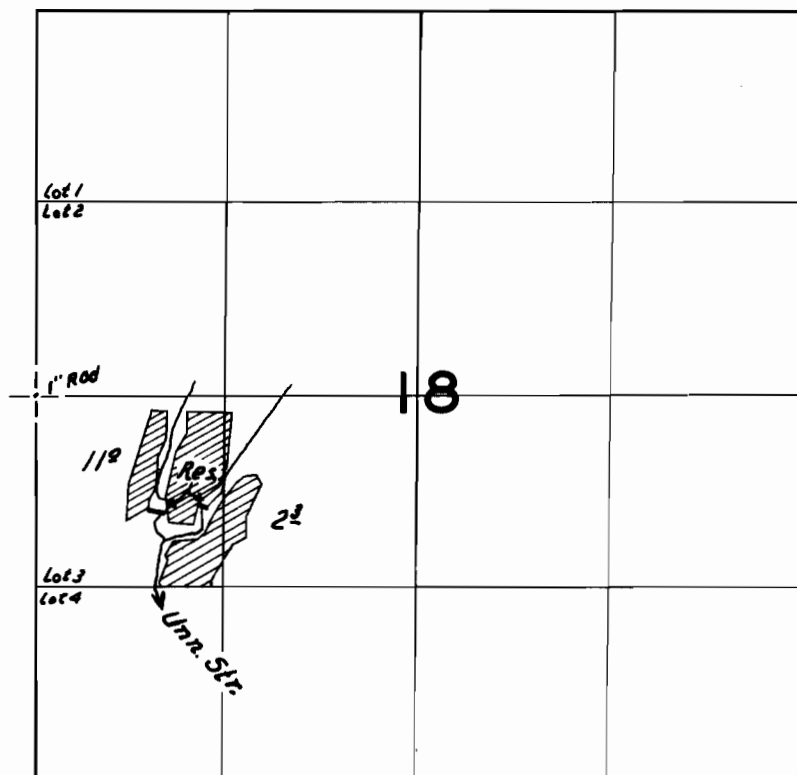

FINAL PROOF SURVEY

UNSUBSIDIZED

R 23115

R 1180

App. No. 23116, Sub. No. 20470

IN NAME OF

Leo Polehn

Surveyed Aug. 28, 1959, by R. H. Jackson